

Client: Sheree & Merren Bailey

Site Address: LOT 3 #20 LAUREL STREET, MALENY, QLD 4552

Design Name: HEARTWOOD 222

Layout Sheet	
A0.1	Cover Sheet
A0.2	Site Plan
A0.3	Floor Plan
A0.4	Elevations 1 of 2
A0.5	Elevations 2 of 2
A0.6	Slab Plan
A0.7	Section A-A
A0.8	Bracing Plan
A0.9	Electrical Plan
A0.10	Kitchen Layout
A0.11	Bathroom Layout
A0.12	Ensuite Layout
A0.13	Laundry Layout
A0.14	GF Kitchen Layout
A0.15	GF Ensuite/Laundry Plan
A0.16	Joinery Details
A0.17	Bathroom Reinforcing Details
A0.18	3d Views



COLOURS, MATERIALS AND FINISHES SHOWN ARE AN ARTISTIC IMPRESSION. PLEASE REFER TO SPECIFICATION FOR CHOSEN PRODUCTS AND FINISHES

"THIS PLAN IS TO BE READ IN CONJUNCTION WITH THE SPECIFICATIONS, QUOTE AND BUILDING CONTRACT. IF ITEMS ARE NOT STATED IN ANY OF THESE DOCUMENTS, IT IS NOT INCLUDED IN YOUR BUILD."

LOT 3 #20 ON SP332484
LOT 3 #20 LAUREL STREET,
MALENY,
Local Authority SUNSHINE COAST REG. COUNCIL
Site Area 1200 **Site Coverage** 24.8%

SERVICES

Power	Underground
Phone	Underground
Water	Meter Box Located
Sewerage	Yes
Stormwater	Kerb at front
Road	Bitumen
Kerb	Mountable
Footpath	Yes (Cut as required)

SITE PLAN LEGEND

- | | |
|---|------------------------------------|
|  | YARD GULLY (BY OWNER) |
|  | ROOF WATER DRAINAGE |
|  | KERB ADAPTER |
|  | ELECTRICAL METER BOX |
|  | ELECTRIC HOT WATER SERVICE |
|  | GAS HOT WATER SERVICE |
|  | AIR CONDITIONING UNIT |
|  | GARDEN TAP |
|  | WATER METER |
|  | GAS BOTTLES |
|  | FIRE HYDRANT |
|  | SLEEPER RETAINING WALL (BY CLIENT) |
|  | EXISTING RETAINING WALL |
|  | EXISTING SPOT LEVEL |
|  | POWER BOX |

 EXACT YARD GULLIES
LOCATIONS TBC ON-SITE

BEST PRACTICE PROCEDURES
FOR EROSION & SEDIMENT
CONTROL AS OUTLINED BY
SUNSHINE COAST REG.
COUNCIL REGULATIONS TO BE
ADHERED TO

SITE NOTES:

1. Should there be any variance in soil conditions to the soil report, consult the engineer.
2. Ground to fall away at a minimum 1:20 for 1000mm, immediately at the dwelling, and directed to a yard gully to prevent ponding and discharged via 90mm separate PVC line & to the legal point of discharge to the satisfaction of the relevant authority.
3. All surface vegetation to be removed from the building pad.
4. Should any tree stumps, rock floaters or similar interfere with the footings, they should be removed and footings to be founded on undisturbed foundation material.

Notes:

UPGRADE ITEMS SHOWN IN RED

Dimensions shall not be obtained by scaling. All dimensions are in millimeters unless noted otherwise. Setout dimensions shall be verified on site prior to any work being carried out. Any problems shall be directed to the builder for clarification & correction



Madden Developments Pty Ltd
ABN: 52 169 872 486
QBSA Lic No: 1284666

107 Sugar Road Maroochydore QLD 4558
Phone: 07 5444 2521
Email: scadmin@stroudhomes.com.au

Client	Sheree & Merren Bailey
Project	LOT 3 #20 LAUREL STREET, MALENY, QLD 4552

Drawing name:
Site Plan

Project status:
CONSTRUCTION


Design: HEARTWOOD 222	Proj. No. 3LAUREL
-----------------------	-------------------


REVISION R3	
CONSTRUCTION PLAN SET 02/03/26 AT	
R1 MARK UPS 20/03/26 AT	
R2 MARK UPS 21/03/26 BT	
R3 MARK UPS 08/05/26 BT	

Wind class:	Flood level:
N3 TBC	TBC
Soil class:	BAL:
TBC	TBC
Plot date:	Noise:
12/05/2026	TBC

Scale:
1:200 @A3


A0.2

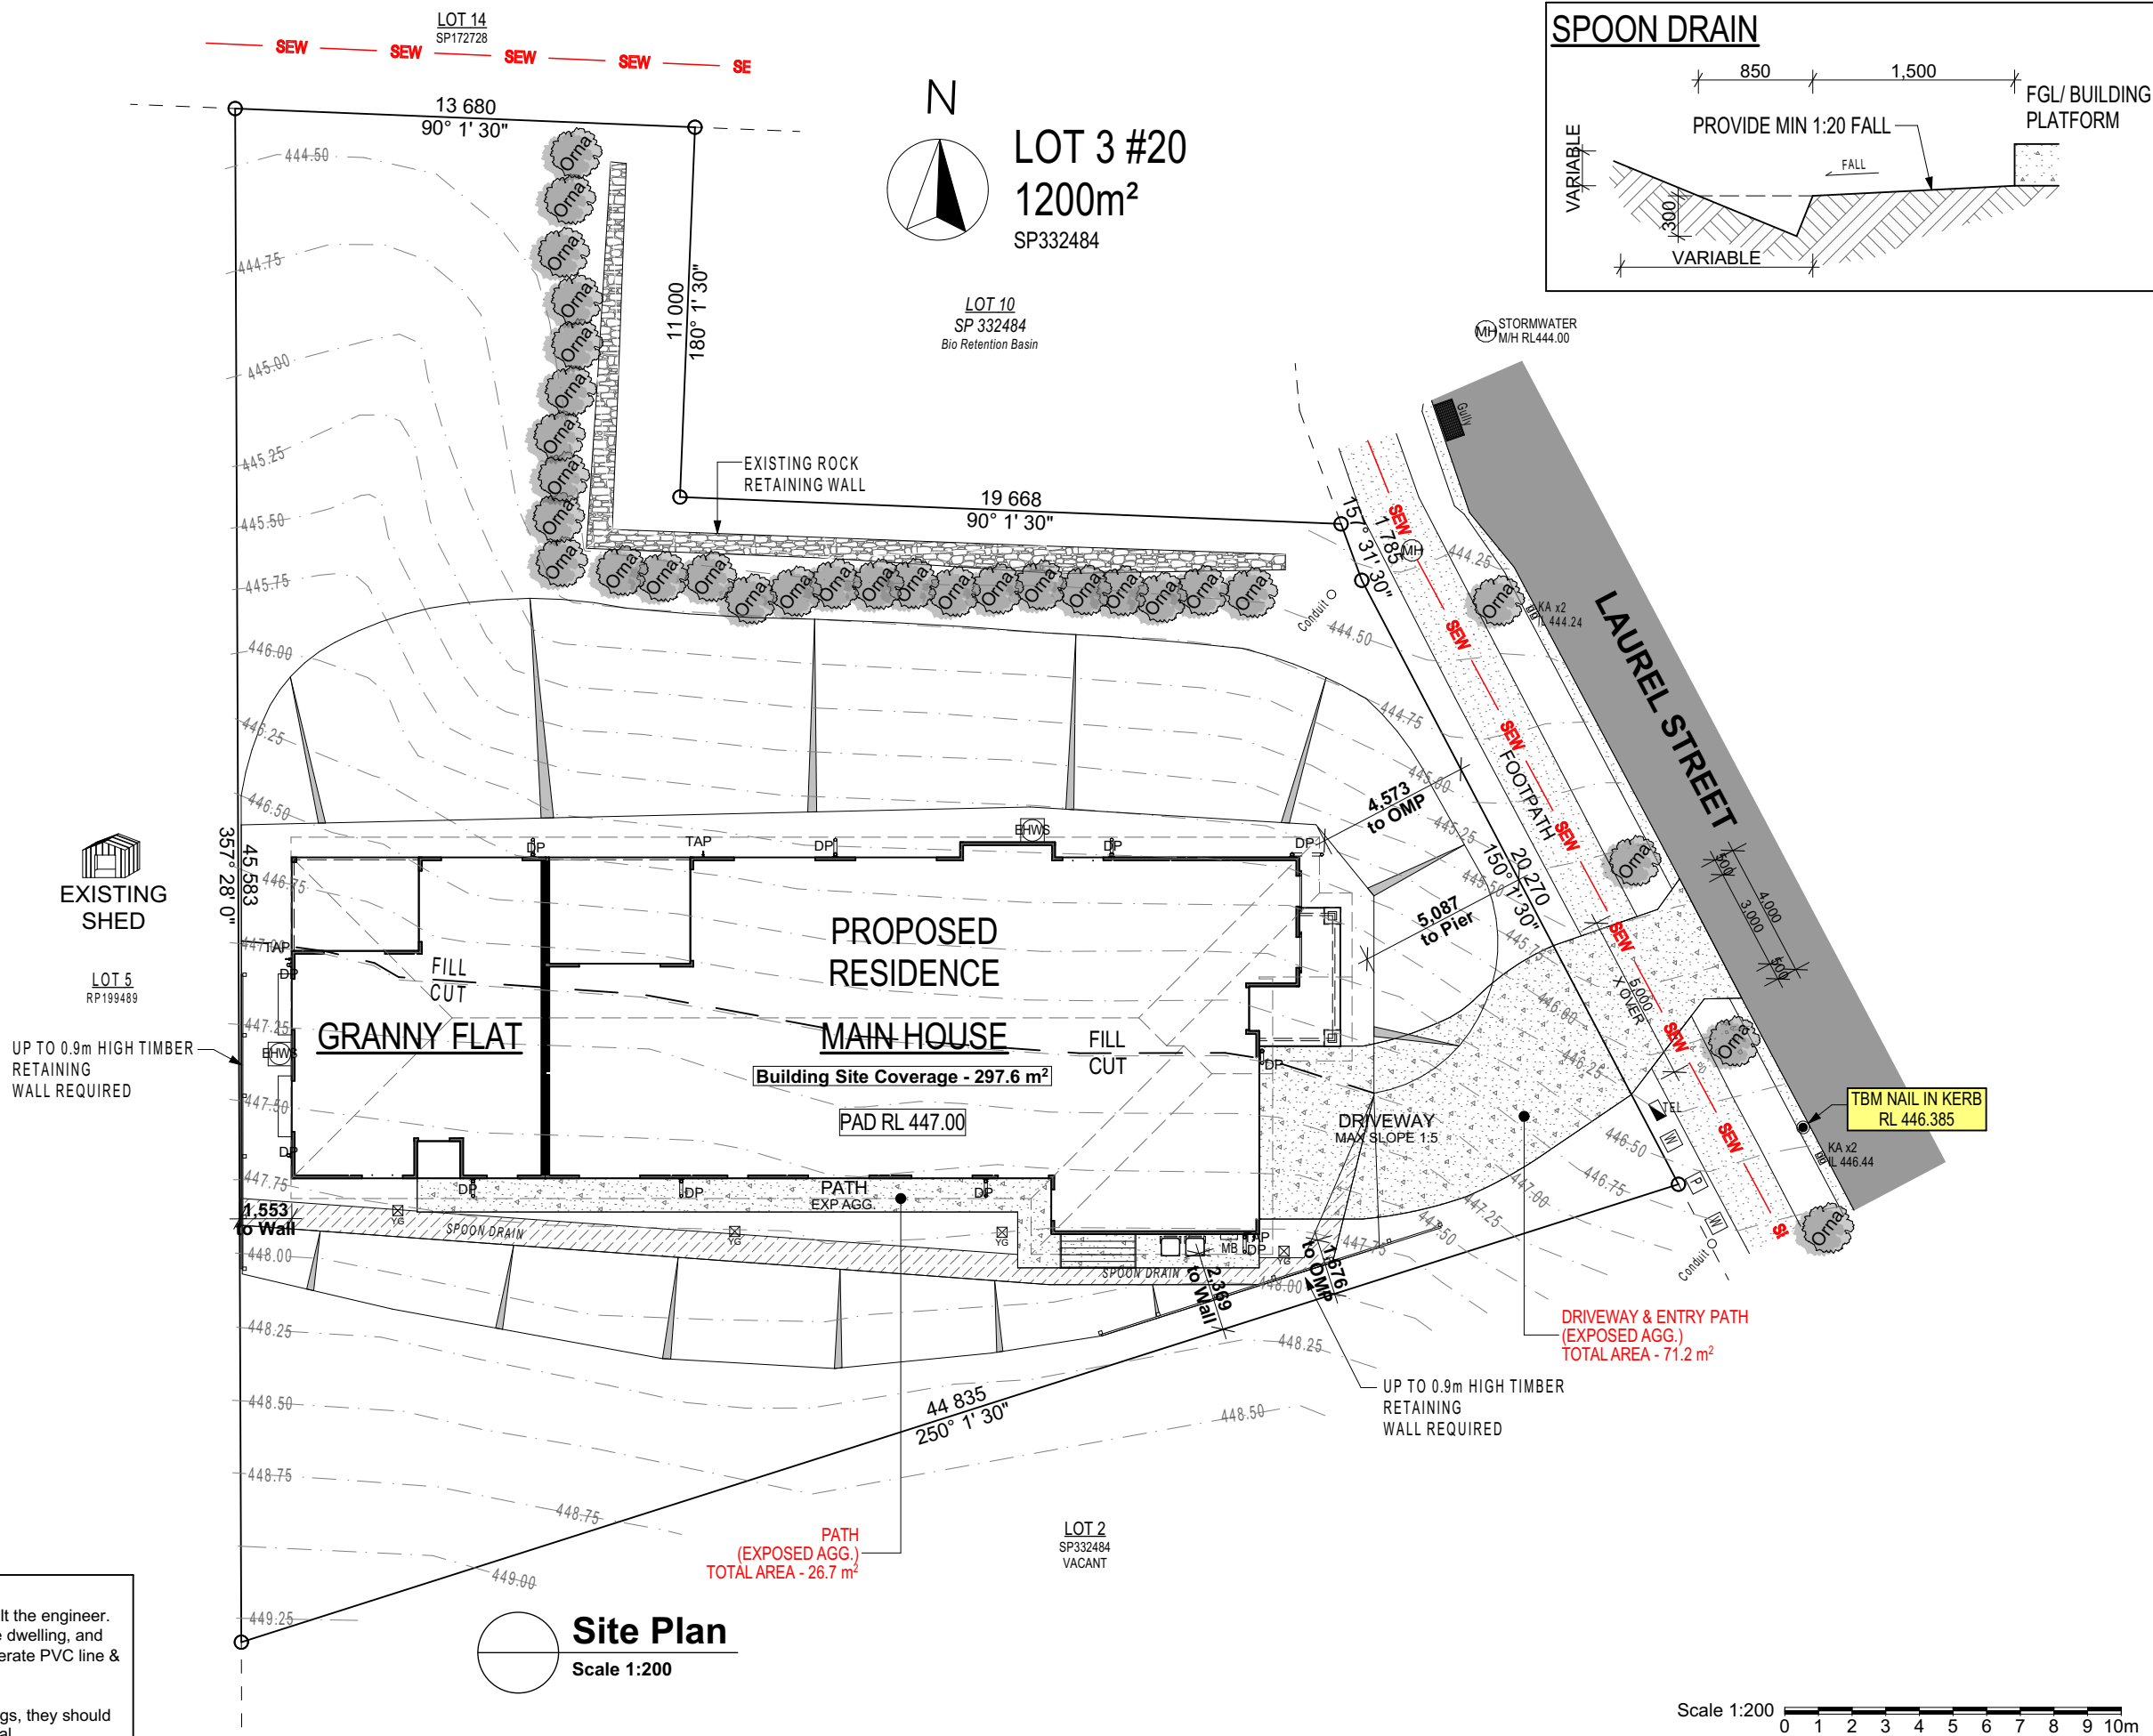

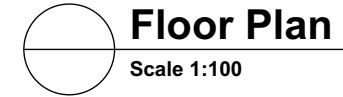


CONSTRUCTION NOTES
- WC DOOR TO HAVE EXTERNAL REMOVABLE
HINGES IN ACCORDANCE WITH NCC 10.4.2


MAIN LIVING AREA:	168.10m ²
GARAGE AREA:	36.40m ²
PORCH AREA:	7.50m ²
ALFRESCO AREA:	13.60m ²
GF LIVING AREA:	60.00m ²
GF ALFRESCO AREA:	10.50m ²
<u>GF PORCH AREA:</u>	<u>1.40m²</u>
TOTAL FLOOR AREA:	297.50m²

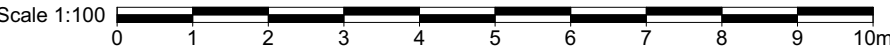

ALL DESIGN CONSTRUCTION & MATERIALS TO BE IN ACCORDANCE WITH:
THE NATIONAL CONSTRUCTION CODE (NCC); THE BUILDING CODE OF AUSTRALIA (BCA); THE QUEENSLAND DEVELOPMENT CODE (QDC); BUILDING REGULATIONS & LOCAL GOVERNMENT PLANS & POLICIES
CURRENT ISSUES OF AUSTRALIAN STANDARDS
CURRENT MANUFACTURERS SPECIFICATIONS & INSTALLATION DETAILS FOR MATERIALS USED

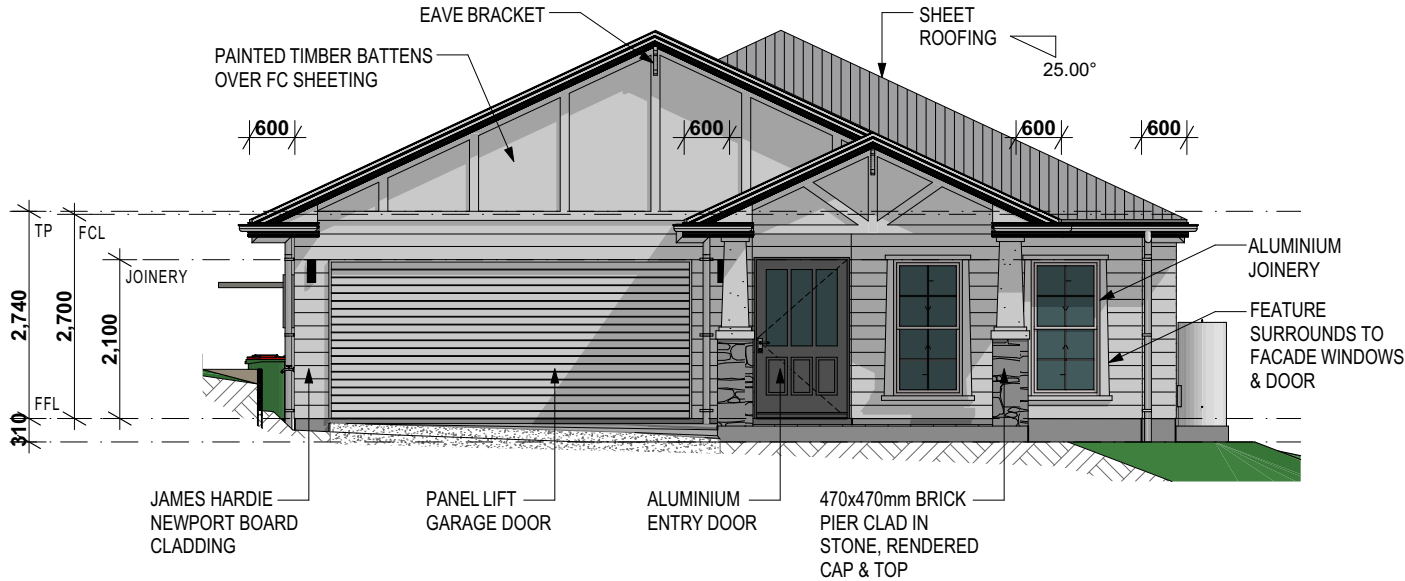

Front
Scale 1:100

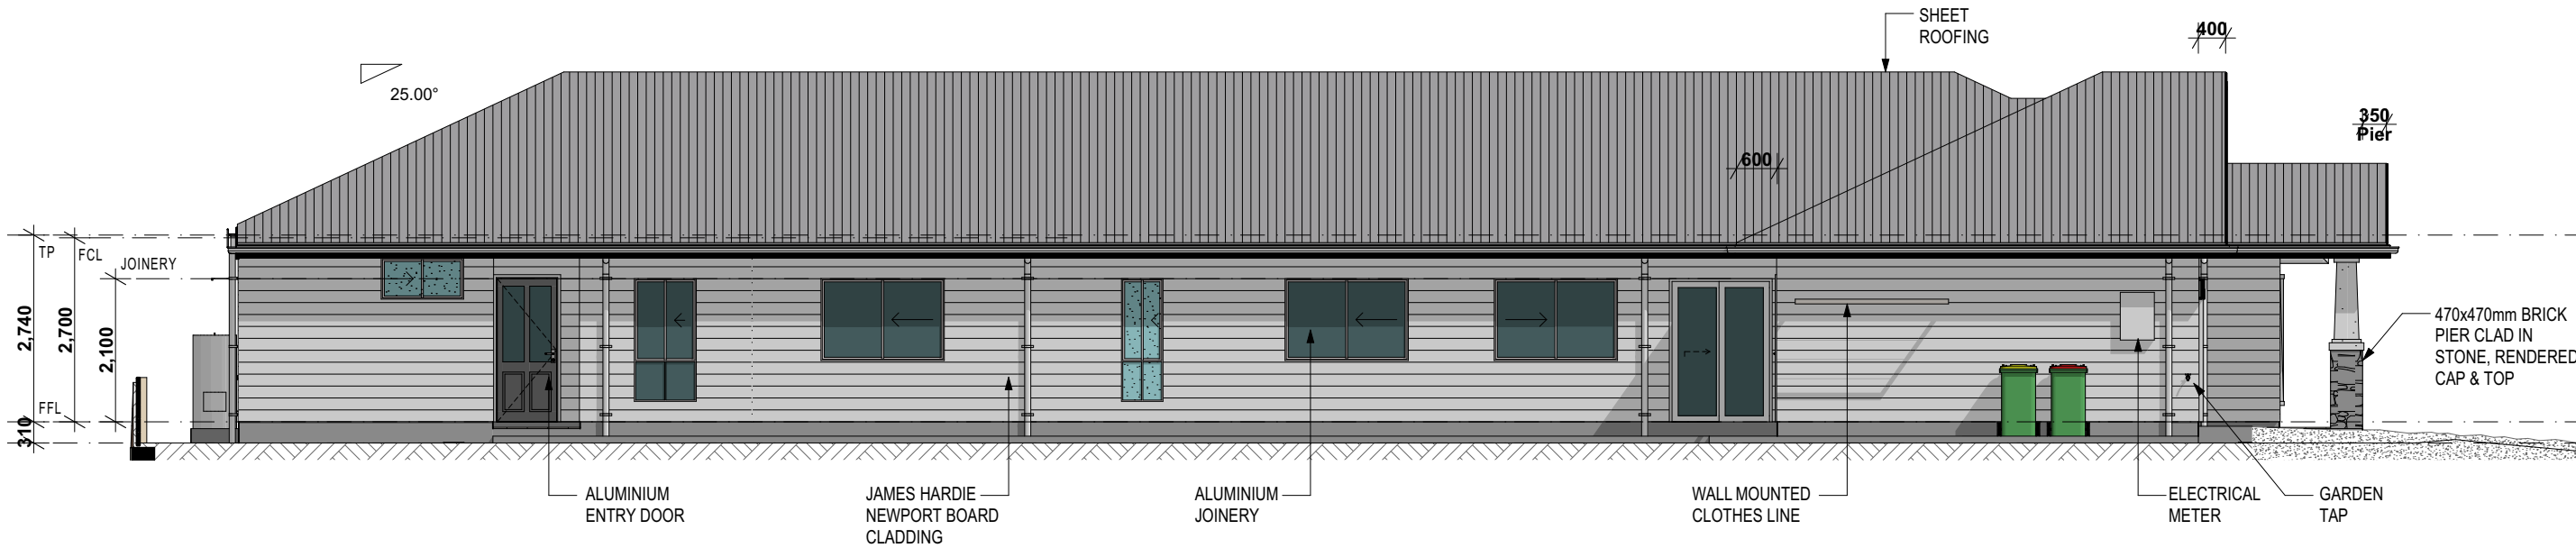

Lhs
Scale 1:100

NOTE:
-ALL OVERHANGS ARE DIMENSIONED FROM OUTSIDE OF TIMBER FRAME
-JOINERY HEIGHTS TO BE 2100 AFL U.N.O.

Copyright Notice: All house plans produced by the builder and the information contained within these documents are the exclusive property of the builder. These house plans cannot be copied or reproduced, in part or in whole in any form or by any method without the express written consent of the builder. The house plans provided by the builder are only to be constructed by Stroud Homes.

Notes:
UPGRADE ITEMS SHOWN IN RED
Dimensions shall not be obtained by scaling. All dimensions are in millimeters unless noted otherwise. Setout dimensions shall be verified on site prior to any work being carried out. Any problems shall be directed to the builder for clarification & correction



Madden Developments Pty Ltd
ABN: 52 169 872 486
QBSA Lic No: 1284666
107 Sugar Road Maroochydore QLD 4558,
Phone: 07 5444 2521
Email: scadmin@stroudhomes.com.au

Client
Sheree & Merren Bailey
Project
LOT 3 #20 LAUREL STREET, MALENY, QLD 4552

Drawing name:
Elevations 1 of 2
Project status:
CONSTRUCTION
Design: HEARTWOOD 222
Proj. No. 3LAUREL

REVISION R3


CONSTRUCTION PLAN SET 02/03/26 AT
R1 MARK UPS 20/03/26 AT
R2 MARK UPS 21/03/26 BT
R3 MARK UPS 08/05/26 BT

Wind class:
N3 TBC
Soil class:
TBC
Plot date:
12/05/2026


Flood level:
TBC
Noise:
TBC

Scale:
1:100 @A3
A0.4

ALL DESIGN CONSTRUCTION & MATERIALS TO BE IN ACCORDANCE WITH:
THE NATIONAL CONSTRUCTION CODE (NCC); THE BUILDING CODE OF AUSTRALIA (BCA); THE QUEENSLAND DEVELOPMENT CODE (QDC); BUILDING REGULATIONS & LOCAL GOVERNMENT PLANS & POLICIES
CURRENT ISSUES OF AUSTRALIAN STANDARDS
CURRENT MANUFACTURERS SPECIFICATIONS & INSTALLATION DETAILS FOR MATERIALS USED

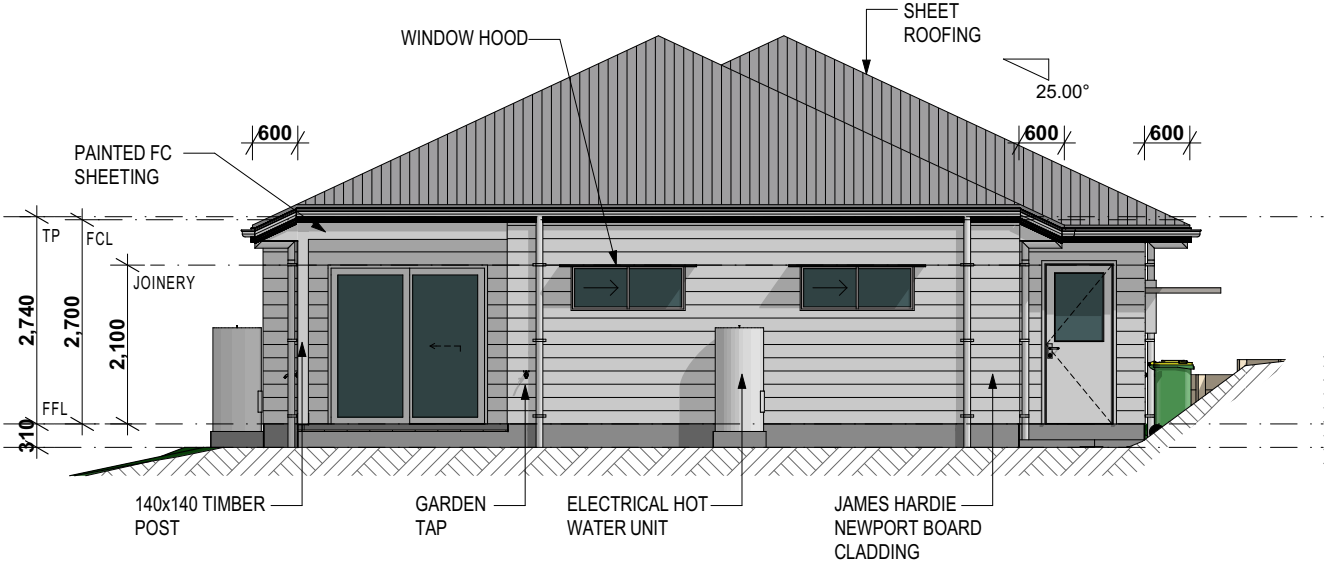

Rear
Scale 1:100

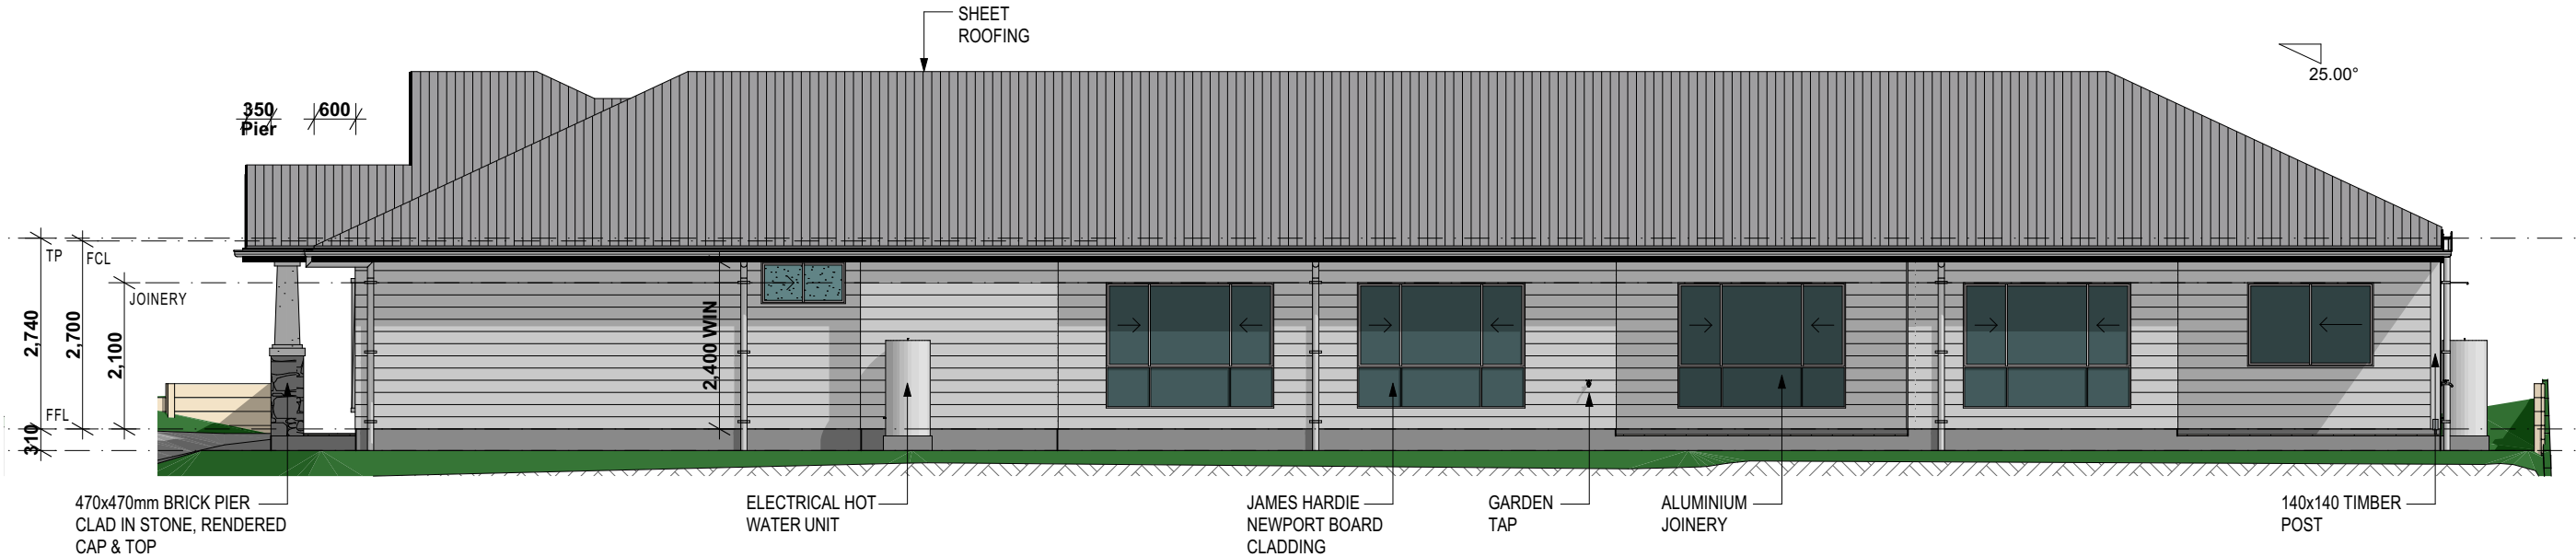

Rhs
Scale 1:100

NOTE:
-ALL OVERHANGS ARE DIMENSIONED FROM OUTSIDE OF TIMBER FRAME
-JOINERY HEIGHTS TO BE 2100 AFL U.N.O.

Copyright Notice: All house plans produced by the builder and the information contained within these documents are the exclusive property of the builder. These house plans cannot be copied or reproduced, in part or in whole in any form or by any method without the express written consent of the builder. The house plans provided by the builder are only to be constructed by Stroud Homes.

Notes:
UPGRADE ITEMS SHOWN IN RED
Dimensions shall not be obtained by scaling. All dimensions are in millimeters unless noted otherwise. Setout dimensions shall be verified on site prior to any work being carried out. Any problems shall be directed to the builder for clarification & correction



Madden Developments Pty Ltd
ABN: 52 169 872 486
QBSA Lic No: 1284666
107 Sugar Road Maroochydore QLD 4558,
Phone: 07 5444 2521
Email: scadmin@stroudhomes.com.au

Client
Sheree & Merren Bailey
Project
LOT 3 #20 LAUREL STREET, MALENY, QLD 4552


Drawing name:
Elevations 2 of 2
Project status:
CONSTRUCTION
Design: HEARTWOOD 222
Proj. No. 3LAUREL

REVISION R3	
CONSTRUCTION PLAN SET 02/03/26 AT	
R1 MARK UPS 20/03/26 AT	
R2 MARK UPS 21/03/26 BT	
R3 MARK UPS 08/05/26 BT	

Wind class:	Flood level:	Scale:
N3 TBC	TBC	1:100 @A3
Soil class:	BAL:	
TBC	TBC	
Plot date:	Noise:	
12/05/2026	TBC	

A0.5

ALL DESIGN CONSTRUCTION & MATERIALS TO BE IN ACCORDANCE WITH:
THE NATIONAL CONSTRUCTION CODE (NCC); THE BUILDING CODE OF AUSTRALIA (BCA); THE QUEENSLAND DEVELOPMENT CODE (QDC); BUILDING REGULATIONS & LOCAL GOVERNMENT PLANS & POLICIES
CURRENT ISSUES OF AUSTRALIAN STANDARDS
CURRENT MANUFACTURERS SPECIFICATIONS & INSTALLATION DETAILS FOR MATERIALS USED

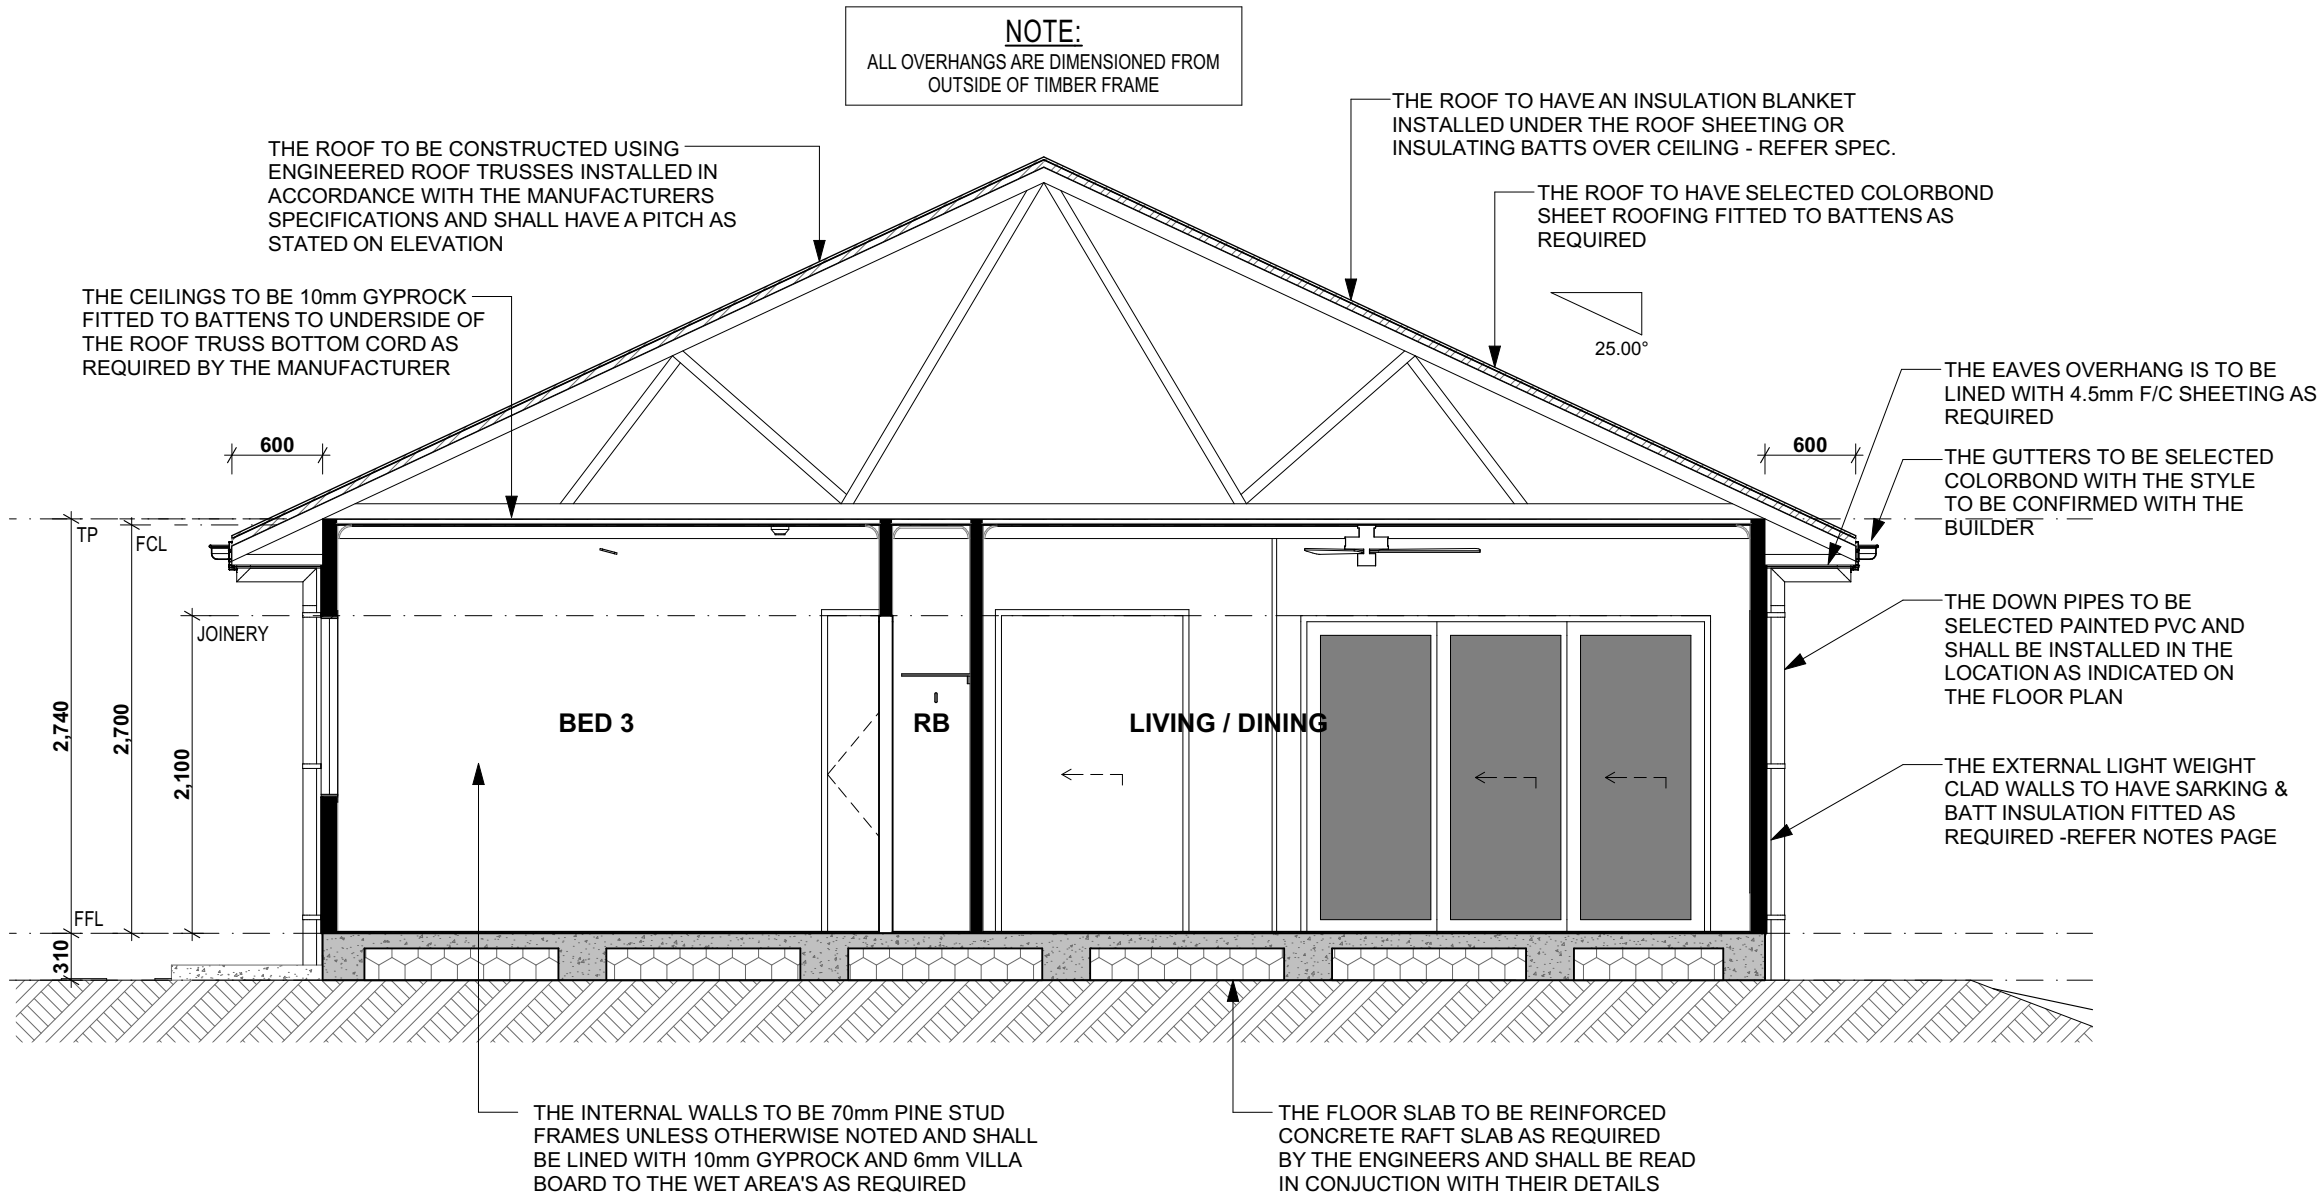

Section A-A
Scale 1:50

Copyright Notice: All house plans produced by the builder and the information contained within these documents are the exclusive property of the builder. These house plans cannot be copied or reproduced, in part or in whole in any form or by any method without the express written consent of the builder. The house plans provided by the builder are only to be constructed by Stroud Homes.

Notes:
UPGRADE ITEMS SHOWN IN RED
Dimensions shall not be obtained by scaling. All dimensions are in millimeters unless noted otherwise. Setout dimensions shall be verified on site prior to any work being carried out. Any problems shall be directed to the builder for clarification & correction



Madden Developments Pty Ltd
ABN: 52 169 872 486
QBSA Lic No: 1284666
107 Sugar Road Maroochydore QLD 4558,
Phone: 07 5444 2521
Email: scadmin@stroudhomes.com.au

Client
Sheree & Merren Bailey
Project
LOT 3 #20 LAUREL STREET, MALENY, QLD 4552

Drawing name:
Section A-A
Project status:
CONSTRUCTION
Design: HEARTWOOD 222 Proj. No. 3LAUREL

REVISION R3	
CONSTRUCTION PLAN SET 02/03/26 AT	
R1 MARK UPS 20/03/26 AT	
R2 MARK UPS 21/03/26 BT	
R3 MARK UPS 08/05/26 BT	

Wind class:	Flood level:	Scale:
N3 TBC	TBC	1:50 @A3
Soil class:	BAL:	
TBC	TBC	
Plot date:	Noise:	
12/05/2026	TBC	


A0.7

(B U2) 26 m² x 1.2 = 31.20kPa

(A U2) 23.1 m² x 1.1 = 25.41kPa

(A) 86.1 m² x 1.1 = 93.71kPa

(B) 31.9 m² x 1.4 = 44.66kPa

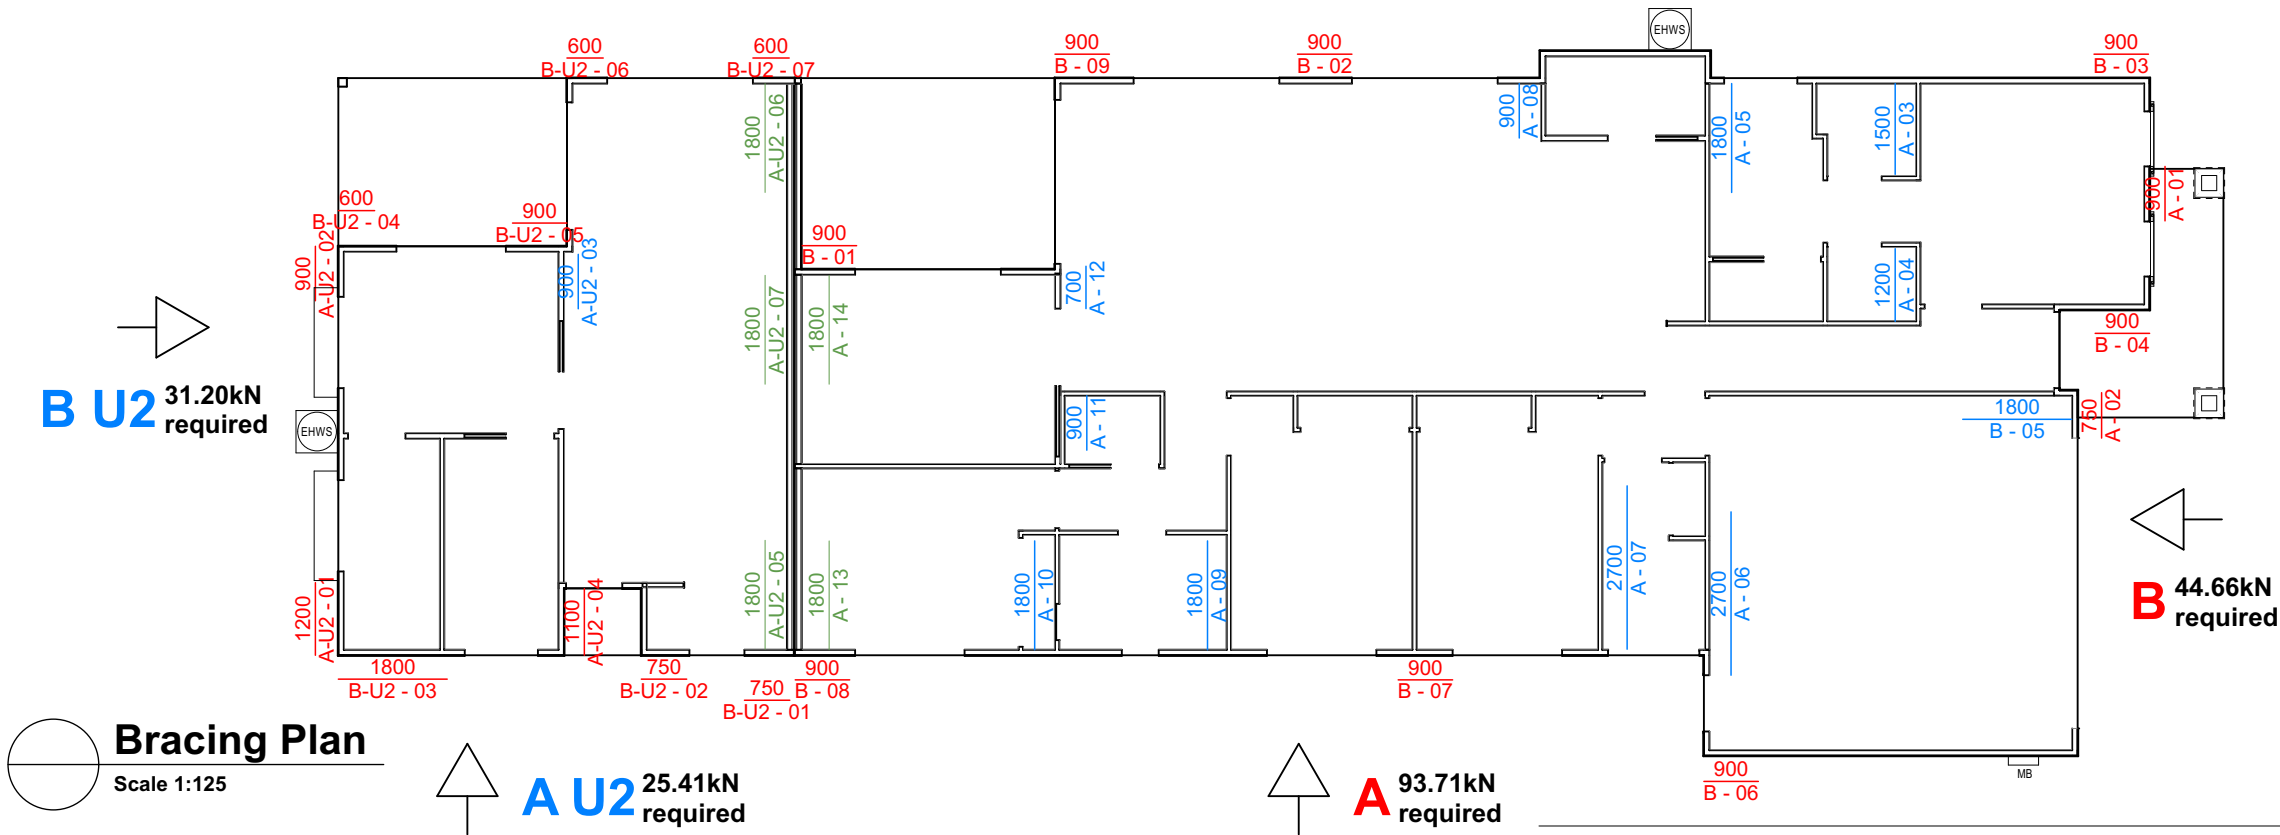

BRACING LEGEND

ALL BRACING AND TIE DOWN TO COMPLY WITH A.S. 1684.2-2021

TYPE C - GALVANISED STEEL ANGLE BRACE IN ACCORDANCE WITH A.S. 1684.2-2021 MANUAL, TABLE 8.18, FIGURE (c) = 1.5kN/M

TYPE H - STRUCTURAL PLY SHEET BRACING IN ACCORDANCE WITH A.S. 1684.2-2021 MANUAL, TABLE 8.18, FIGURE (h):
METHOD A - 5.6 kN/M
METHOD B - 5.2 kN/M

* PLY BRACING PANELS LESS THAN 900mm LONG TO A MINIMUM WIDTH OF 600mm, TO HAVE 1/M12 ROD AT EACH END IN ACCORDANCE WITH A.S. 1684.2021 CLAUSE 8.3.6.5

BRICK PIERS IN ACCORDANCE WITH "BRICK DEVELOPMENT RESEARCH INSTITUTE" CLAY BRICK CONSTRUCTION DETAILS. VOLUME No 1, TABLE 12 = 1.5kN/M IN EACH DIRECTION M4

(B) BRACEBOARD SHEET IN ACCORDANCE WITH AUSTRALIAN HARDBOARDS M4 PRODUCT MANUAL TYPE B = 6.0kN/M

M4(C) BRACEBOARD SHEET IN ACCORDANCE WITH AUSTRALIAN HARDBOARDS M4 PRODUCT MANUAL TYPE H = 9.0kN/M

DOUBLE SIDED BRACING REQUIRES MIN 45mm DEEP BOTTOM PLATE. THE TIE DOWN BRACING WALL SHELL BE DOUBLE AS PROVIDED IN TABLES 8.18(g), (h) AND (i) OR CLAUSE 8.3.6.10 FOR THE INCREASED CAPACITY

ALL DESIGN CONSTRUCTION & MATERIALS TO BE IN ACCORDANCE WITH:

THE NATIONAL CONSTRUCTION CODE (NCC); THE QUEENSLAND DEVELOPMENT CODE (QDC);
BUILDING REGULATIONS & LOCAL GOVERNMENT PLANS & POLICIES
CURRENT ISSUES OF AUSTRALIAN STANDARDS
CURRENT MANUFACTURERS SPECIFICATIONS & INSTALLATION DETAILS FOR MATERIALS USED

N3 BRACING SCHEDULE A U2 - RESISTENCE REQUIRED = 25.41kN

ID	BRACING TYPE	LENGTH	BRACING VALUE (kN/m)	RESISTANCE
A-U2 - 01	1200 Ply - Meth A	1,200	5.600	6.720
A-U2 - 02	900 Ply - Meth A	900	5.600	5.040
A-U2 - 03	900 Ply - Meth B	900	5.200	4.680
A-U2 - 04	1100 Ply - Meth A	1,100	5.600	6.160
A-U2 - 05	1800 Galv. Angle	1,800	1.500	2.700
A-U2 - 06	1800 Galv. Angle	1,800	1.500	2.700
A-U2 - 07	1800 Galv. Angle	1,800	1.500	2.700
				30.700

N3 - BRACING SCHEDULE B U2 - RESISTENCE REQUIRED = 31.20kN

ID	BRACING TYPE	LENGTH	BRACING VALUE (kN/m)	RESISTANCE
B-U2 - 01	750 Ply - Meth A	750	5.600	4.200
B-U2 - 02	750 Ply - Meth A	750	5.600	4.200
B-U2 - 03	1800 Ply - Meth A	1,800	5.600	10.080
B-U2 - 04	600 Ply - Meth A	600	5.600	3.360
B-U2 - 05	900 Ply - Meth A	900	5.600	5.040
B-U2 - 06	600 Ply - Meth A	600	5.600	3.360
B-U2 - 07	600 Ply - Meth A	600	5.600	3.360
				33.600

N3 BRACING SCHEDULE A - RESISTENCE REQUIRED = 93.71kN

ID	BRACING TYPE	LENGTH	BRACING VALUE (kN/m)	RESISTANCE
A - 01	900 Ply - Meth A	900	5.600	5.040
A - 02	750 Ply - Meth A	750	5.600	4.200
A - 03	1500 Ply - Meth B	1,500	5.200	7.800
A - 04	1200 Ply - Meth B	1,200	5.200	6.240
A - 05	1800 Ply - Meth B	1,800	5.200	9.360
A - 06	2700 Ply - Meth B	2,700	5.200	14.040
A - 07	2700 Ply - Meth B	2,700	5.200	14.040
A - 08	900 Ply - Meth B	900	5.200	4.680
A - 09	1800 Ply - Meth B	1,800	5.200	9.360
A - 10	1800 Ply - Meth B	1,800	5.200	9.360
A - 11	900 Ply - Meth B	900	5.200	4.680
A - 12	700 Ply - Meth B	700	5.200	3.640
A - 13	1800 Galv. Angle	1,800	1.500	2.700
A - 14	1800 Galv. Angle	1,800	1.500	2.700
				97.840

N3 - BRACING SCHEDULE B - RESISTENCE REQUIRED = 44.66kN

ID	BRACING TYPE	LENGTH	BRACING VALUE (kN/m)	RESISTANCE
B - 01	900 Ply - Meth A	900	5.600	5.040
B - 02	900 Ply - Meth A	900	5.600	5.040
B - 03	900 Ply - Meth A	900	5.600	5.040
B - 04	900 Ply - Meth A	900	5.600	5.040
B - 05	1800 Ply - Meth B	1,800	5.200	9.360
B - 06	900 Ply - Meth A	900	5.600	5.040
B - 07	900 Ply - Meth A	900	5.600	5.040
B - 08	900 Ply - Meth A	900	5.600	5.040
B - 09	900 Ply - Meth A	900	5.600	5.040
				49.680

Copyright Notice: All house plans produced by the builder and the information contained within these documents are the exclusive property of the builder. These house plans cannot be copied or reproduced, in part or in whole in any form or by any method without the express written consent of the builder. The house plans provided by the builder are only to be constructed by Stroud Homes.

Notes:

UPGRADE ITEMS SHOWN IN RED

Dimensions shall not be obtained by scaling. All dimensions are in millimeters unless noted otherwise. Setout dimensions shall be verified on site prior to any work being carried out. Any problems shall be directed to the builder for clarification & correction



Madden Developments Pty Ltd
ABN: 52 169 872 486
QBSA Lic No: 1284666
107 Sugar Road Maroochydore QLD 4558,
Phone: 07 5444 2521
Email: scadmin@stroudhomes.com.au

Client
Sheree & Merren Bailey
Project
LOT 3 #20 LAUREL STREET, MALENY, QLD 4552

Drawing name:
Bracing Plan
Project status:
CONSTRUCTION

Design: HEARTWOOD 222

Proj. No. 3LAUREL


REVISION R3

CONSTRUCTION PLAN SET 02/03/26 AT
R1 MARK UPS 20/03/26 AT
R2 MARK UPS 21/03/26 BT
R3 MARK UPS 08/05/26 BT


Wind class:
N3 TBC
Soil class:
TBC
Plot date:
12/05/2026

Flood level:
TBC
Noise:
TBC

Scale:
1:125 @A3
A0.8

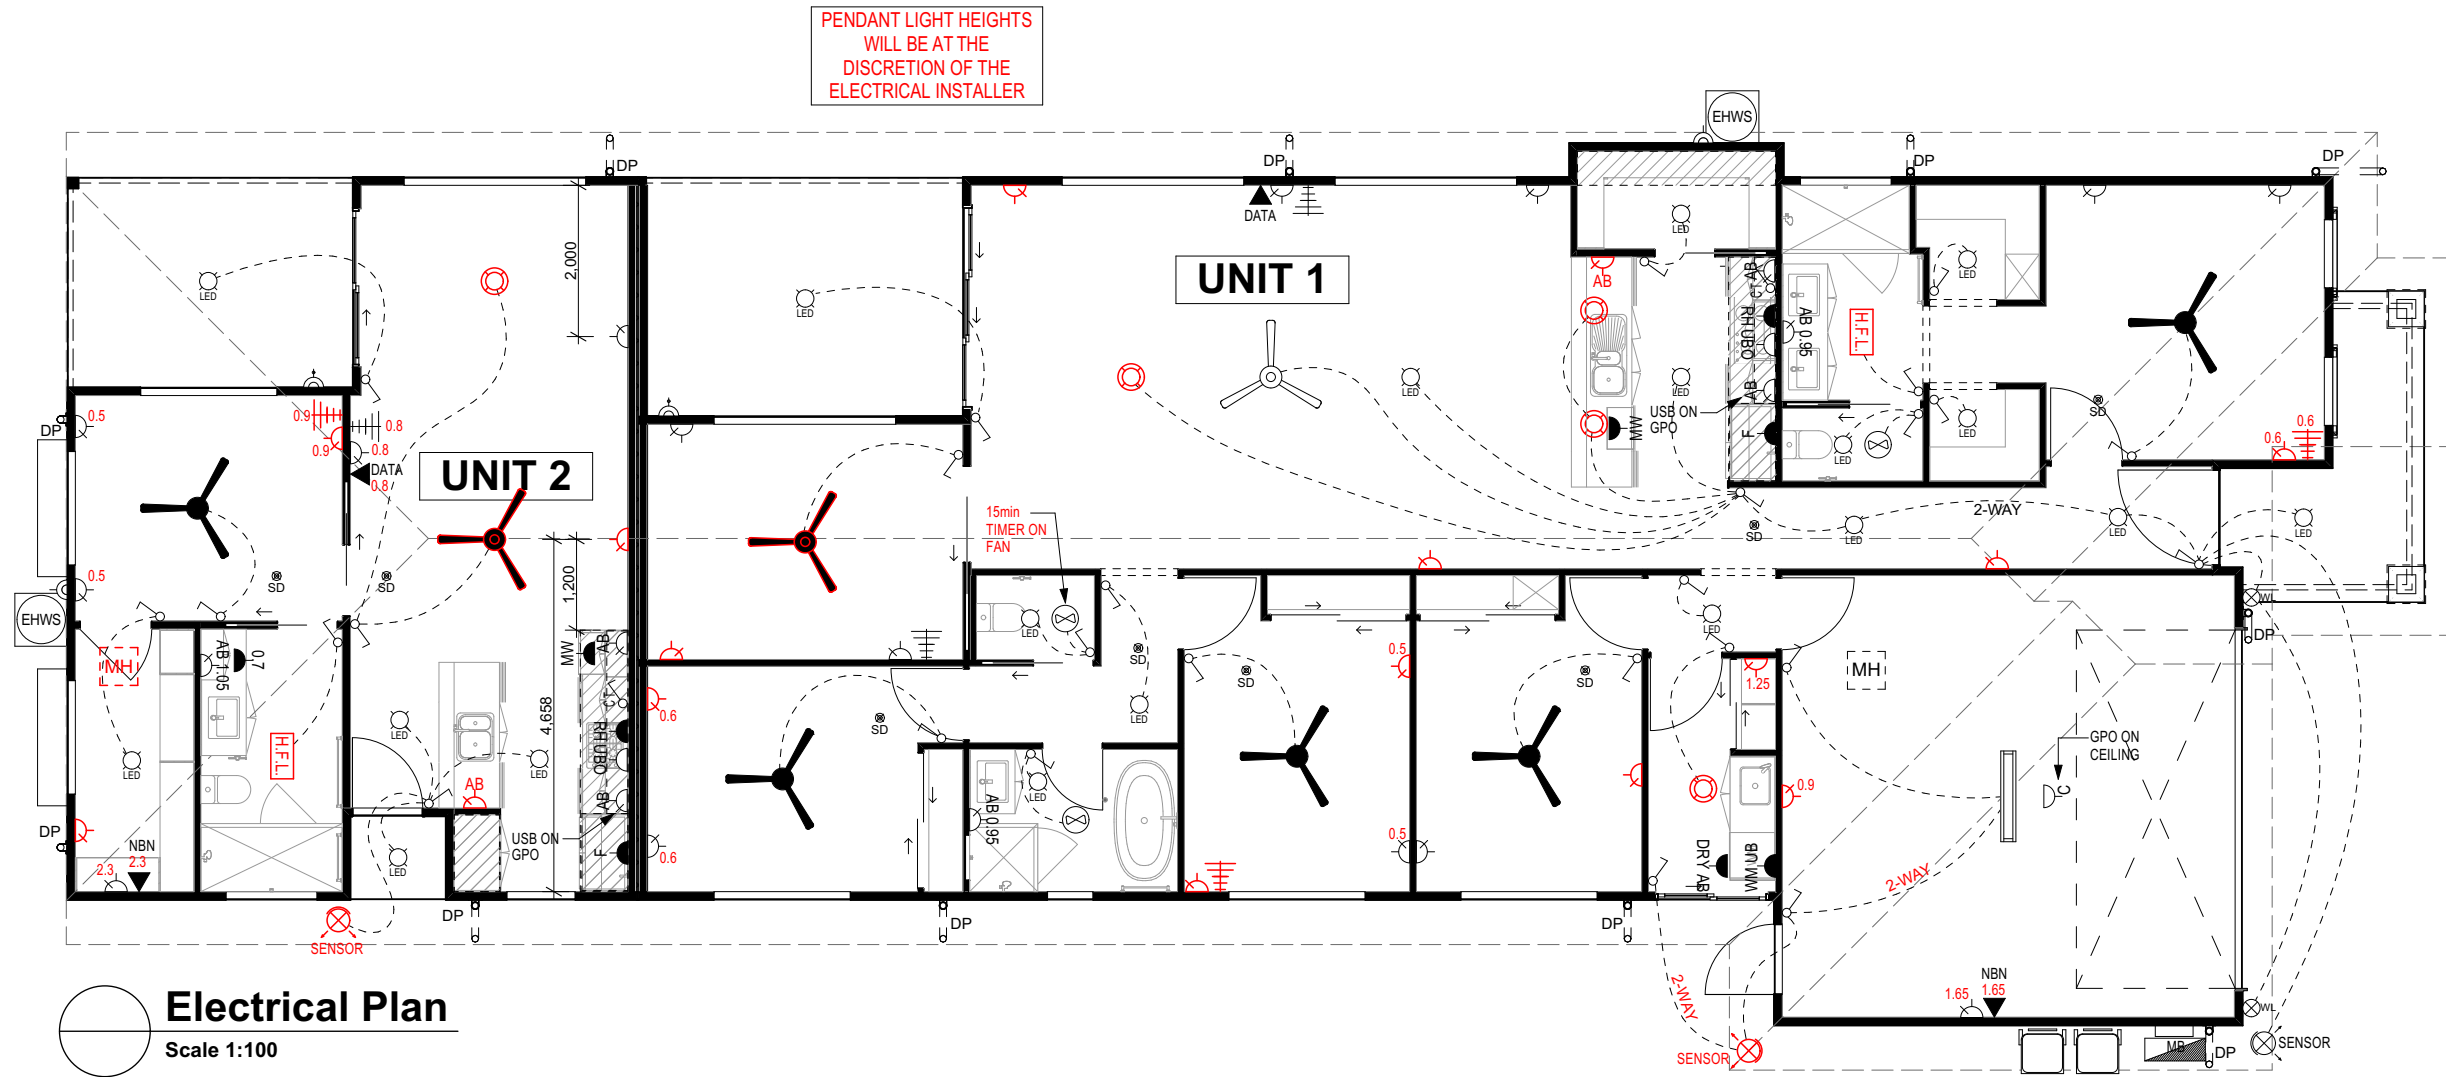

ELECTRICAL LEGEND

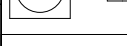 OR 	LED LIGHT/ LED ON SENSOR		GPO SGL/DBL WITH RELATIVE NOTES		AIR CONDITIONING UNIT INTERNAL SPLIT SYSTEM
	FLUORESCENT LIGHT		LIGHT SWITCH		METER BOX -LOCATION T.B.C. ON SITE
	WALL MOUNTED LIGHT LOCATED 2.1m FROM F.F.L		TV POINT		CEILING FAN
	SPOTLIGHT LOCATED ON SOFFIT		HARD WIRED INTERCONNECTED SMOKE DETECTOR		CEILING FAN - WITH LIGHT
	DOUBLE GPO		MECHANICAL VENTILLATION FAN		AIR CONDITIONING VENT LOCATED IN CEILING/BULKHEAD
	SINGLE GPO		NATIONAL BROADBAND NETWORK OUTLET 1.1 AFL (GARAGE) DATA/PHONE 0.3 AFL IN HOUSE		AIR CONDITIONING CONTROL PANEL LOCATED 1.3m FROM F.F.L
	MICROWAVE / DISHWASHER SINGLE GPO UNDER BENCH		ELECTRIC / GAS HOT WATER SERVICE		RETURN AIR VENT
	HARDWIRED ISOLATOR SWITCH @1.1m FROM F.F.L		AIR CONDITIONING EXTERNAL UNIT		
	DBL WEATHERPROOF OUTLET @1.1m FROM F.F.L				

GENERAL NOTES:

-GPO HEIGHTS TO BE 300mm AFL UNLESS ABOVE A BENCH (AB) WHERE THEY SHALL BE @1050mm AFL U.N.O.
-ALL LIGHT SWITCHES (WALL PLATES) TO BE @1100-1300mm U.N.O.
-ALLOW FOR RANGEHOOD INSTALLATION OVER STOVE /COOKTOPS
-ALL A/C UNITS TO BE PROVIDED WITH POWER AS APPLICABLE HEIGHT, W.P. SPP AND ISOLATION SWITCH TO EXTERIOR.
-DIRECT WIRING TO ELECTRICAL OVENS,UP RIGHT COOKERS, & HWS UNITS.
-WHERE APPLICABLE, WIRING TO BE PROVIDED IN SLAB TO KITCHEN ISLAND BENCH.
-ENERGY EFFICIENT LIGHTING FOR A MINIMUM OF 80% OF TOTAL FIXED INTERNAL LIGHTING AS PER SUSTAINABLE HOUSING REQUIREMENTS
-STANDARD TV ANTENNA MOUNTED ON ROOF AS TYPICAL.

KITCHEN POWER OUTLETS:

-ALL SINGLE & DOUBLE POWER POINTS FOR ISLAND BENCH @ 750mm (IF REQUIRED)
-RANGEHOOD POWER POINT @1800 OR AS PER APPLIANCE SPEC.
-REFRIGERATOR POWER POINT @1900
-PROVISION FOR SEPARATE POWER POINTS FOR WALL OVEN TOWERS, MICROWAVES, & DISHWASHERS IF APPLICABLE AS REQUIRED

LAUNDRY POWER OUTLETS:

-(NO BENCH OVER) WASHING MACHINE DBL POWERPOINT @ 1050mm
-(BENCH OVER) 1x WASHING MACHINE POWERPOINTS@ 700mm & 1x DRYER POINT OVER @ 1050mm

ELECTRICAL NOTE:

- ENSURE ALL ELECTRICAL WORK IS INSTALLED AS PER THE RELEVANT AUSTRALIAN STANDARDS.
- EXACT LOCATION AND QTY OF ELECTRICAL POINTS MAY VARY ON SITE DUE TO CONSTRUCTION REQUIREMENTS
- ALL SMOKE ALARMS MUST BE INSTALLED AS PER RELEVANT STANDARDS. IF THE LOCATION OF SMOKE ALARMS ON THE PLANS DOES NOT COMPLY, PLEASE MOVE THEM TO THE CORRECT ON LOCATION ON SITE.

Copyright Notice: All house plans produced by the builder and the information contained within these documents are the exclusive property of the builder. These house plans cannot be copied or reproduced, in part or in whole in any form or by any method without the express written consent of the builder. The house plans provided by the builder are only to be constructed by Stroud Homes.

Notes:

UPGRADE ITEMS SHOWN IN RED

Dimensions shall not be obtained by scaling. All dimensions are in millimeters unless noted otherwise. Setout dimensions shall be verified on site prior to any work being carried out. Any problems shall be directed to the builder for clarification & correction



Madden Developments Pty Ltd
ABN: 52 169 872 486
QBSA Lic No: 1284666
107 Sugar Road Maroochydore QLD 4558,
Phone: 07 5444 2521
Email: scadmin@stroudhomes.com.au

Client
Sheree & Merren Bailey
Project
LOT 3 #20 LAUREL STREET, MALENY, QLD 4552

Drawing name:
Electrical Plan
Project status:
CONSTRUCTION

Design: HEARTWOOD 222 Proj. No. 3LAUREL


REVISION R3

CONSTRUCTION PLAN SET 02/03/26 AT
R1 MARK UPS 20/03/26 AT
R2 MARK UPS 21/03/26 BT
R3 MARK UPS 08/05/26 BT

Wind class:
N3 TBC
Soil class:
TBC
Plot date:
12/05/2026


Flood level:
TBC
BAL:
TBC
Noise:
TBC

Scale:
1:100 @A3
A0.9

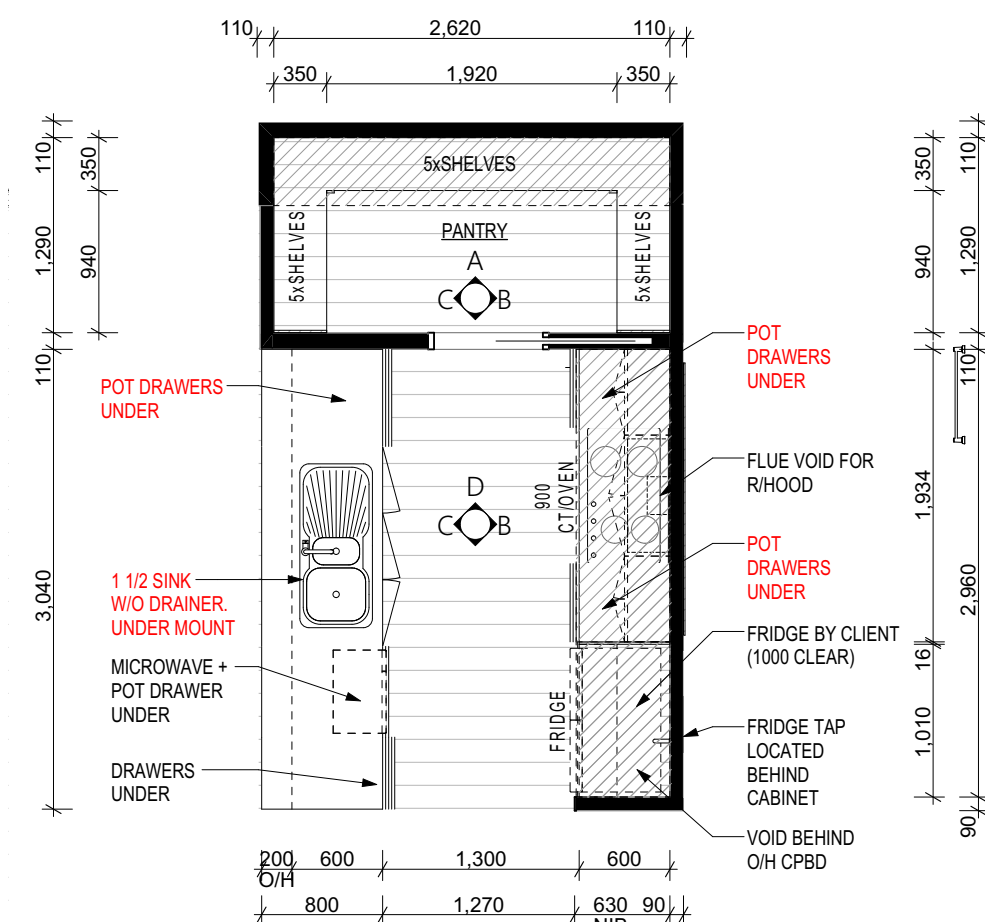


Kitchen Plan
Scale 1:50


DISCLAIMER NOTE:
The builder has identified that occasionally cabinetry layouts, plumbing locations, and fit off items are not achievable. Final cabinetry layouts, plumbing setouts, and fit off item locations & dimensions are approximate only & are subject to change. Final shop drawings are to be completed by a suitably qualified contractor to ensure that all works are carried out to meet relevant building codes. The builder endeavors to provide an exact layout but this is not always possible.
Dimensions shown are from the outside of the plasterboard and not from frame. Site measure required before cabinetry design and benchtop production.

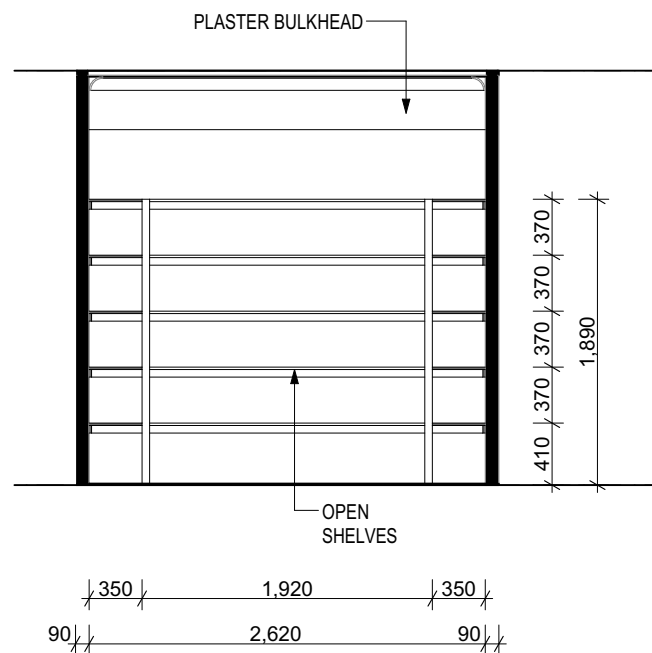


Kitchen A
Scale 1:50

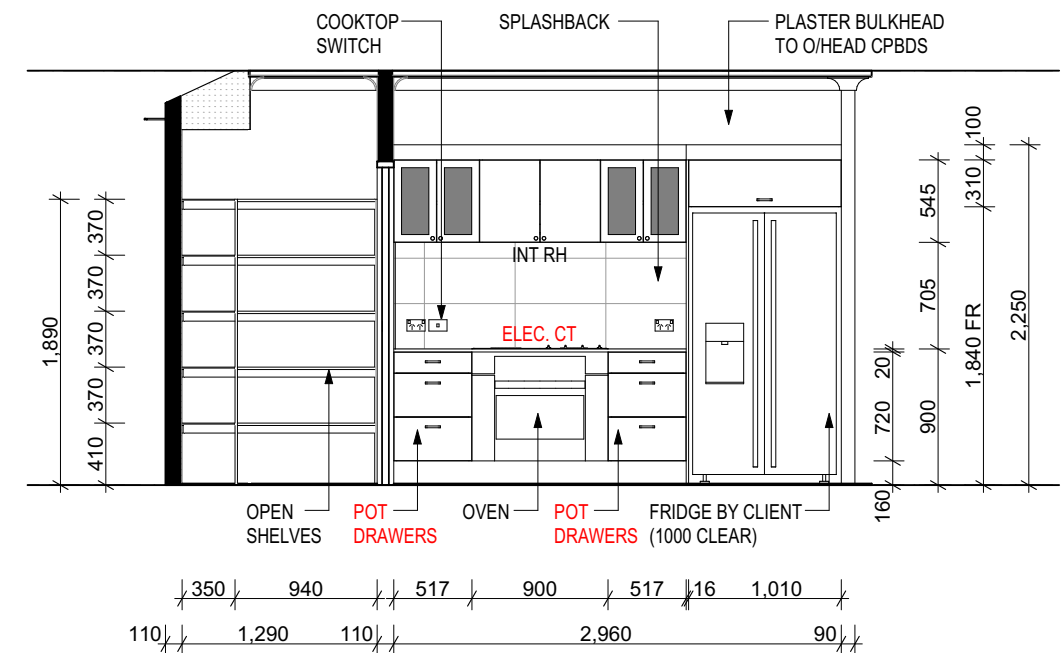


Kitchen B
Scale 1:50

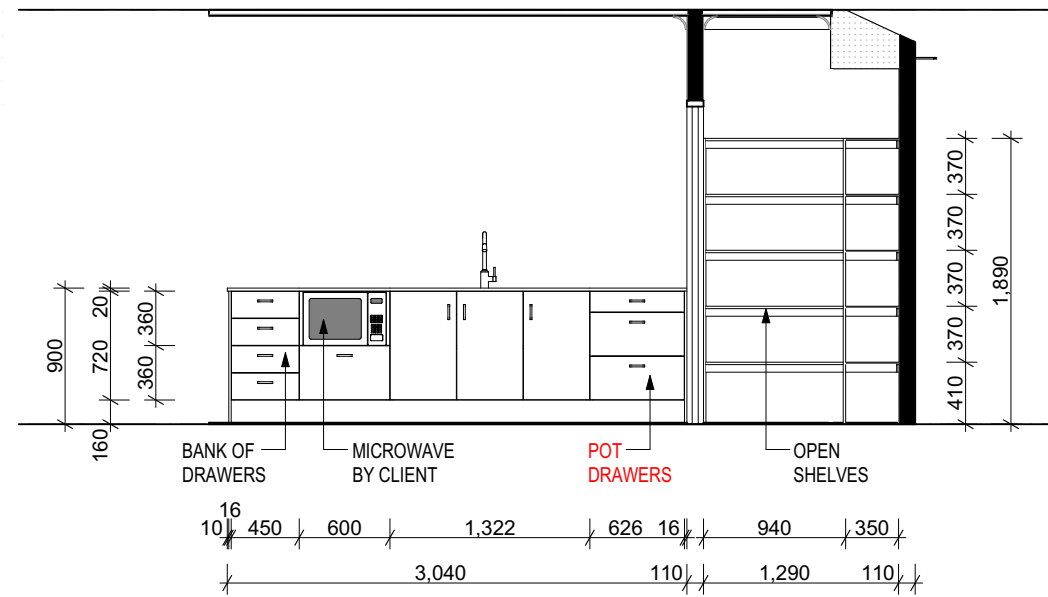

Kitchen C
Scale 1:50

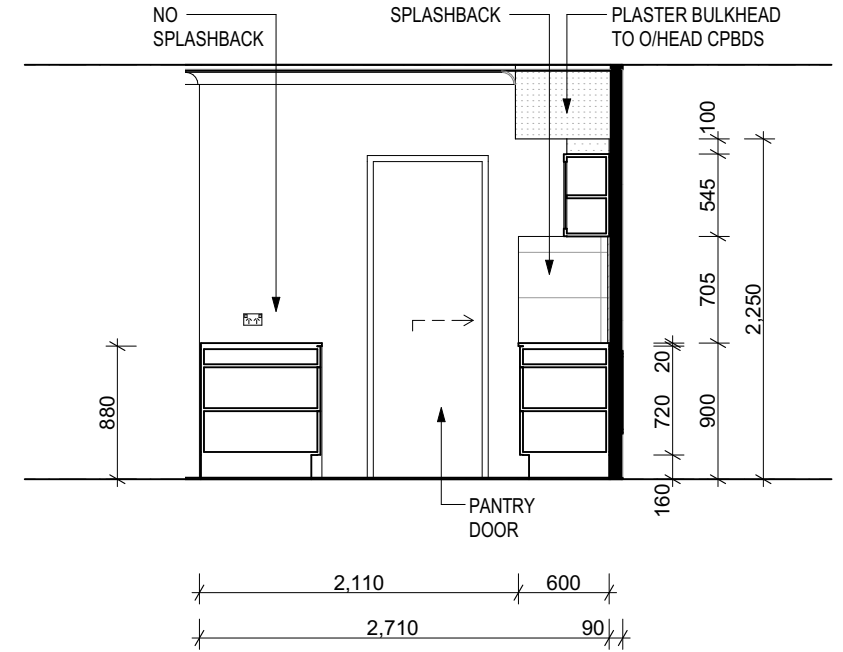

Kitchen D
Scale 1:50

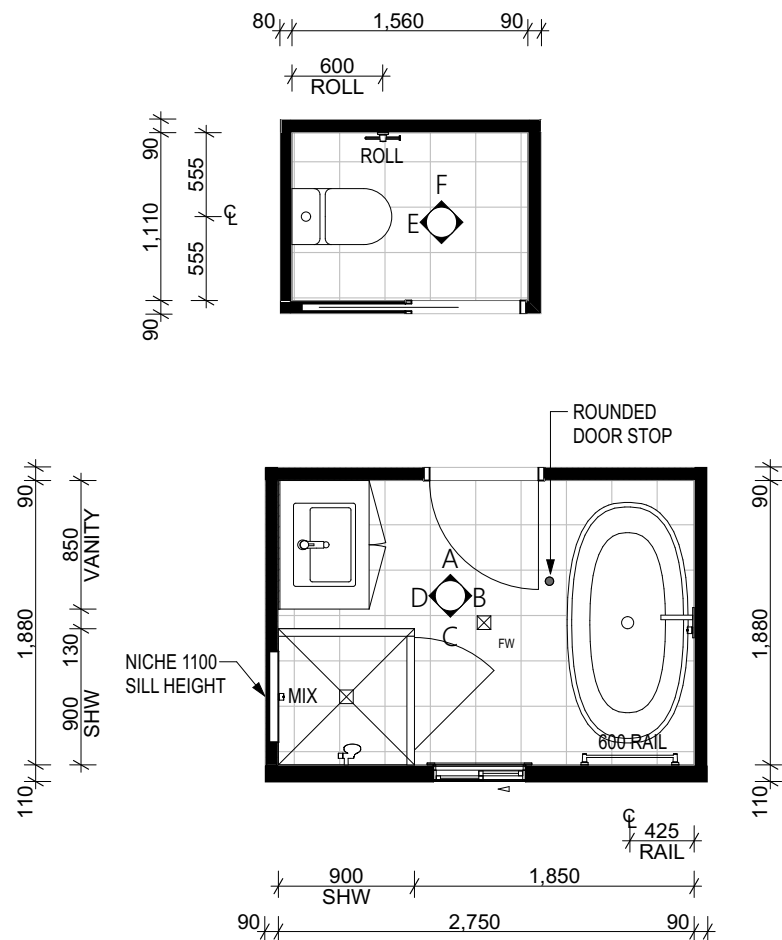

BATHROOM NOTES:
OVER FLOWS AND STOP VALVES REQUIRED TO
BATHROOMS WITH FLOOR WASTE


Bathroom & Wc Plan

Scale 1:50

DISCLAIMER NOTE:


The builder has identified that occasionally cabinetry layouts, plumbing locations, and fit off items are not achievable. Final cabinetry layouts, plumbing setouts, and fit off item locations & dimensions are approximate only & are subject to change. Final shop drawings are to be completed by a suitably qualified contractor to ensure that all works are carried out to meet relevant building codes. The builder endeavors to provide an exact layout but this is not always possible.

Dimensions shown are from the outside of the plasterboard and not from frame. Site measure required before cabinetry design and benchtop production.

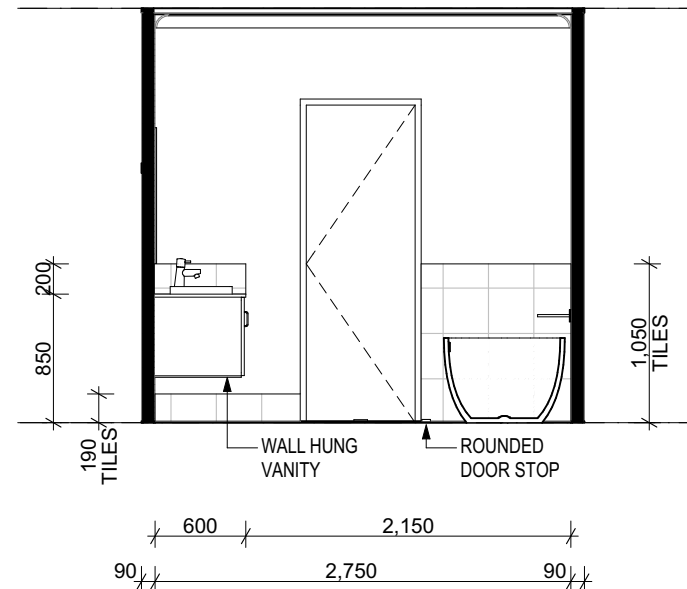


Bathroom A

Scale 1:50

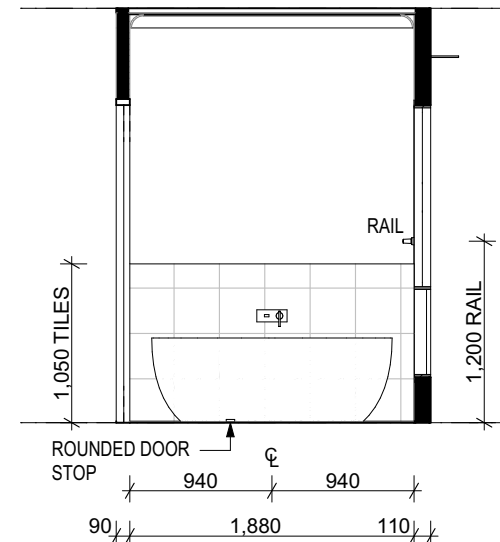


Bathroom B

Scale 1:50

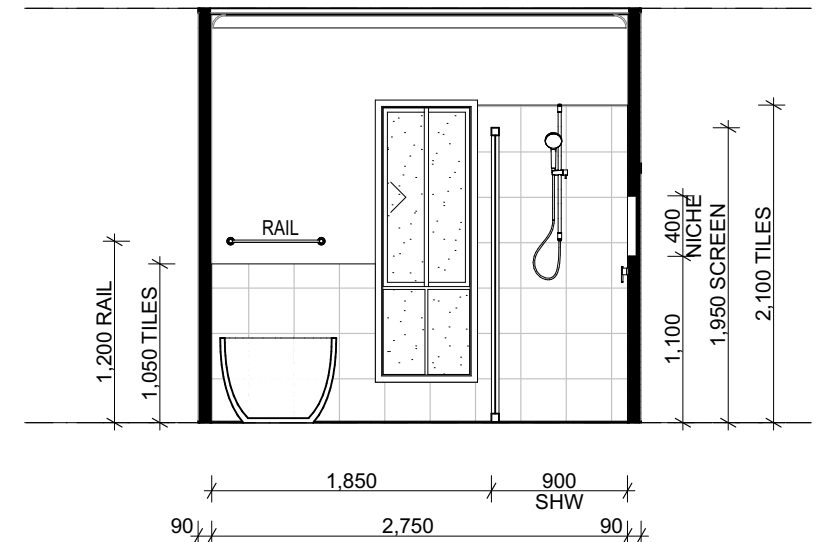


Bathroom C

Scale 1:50

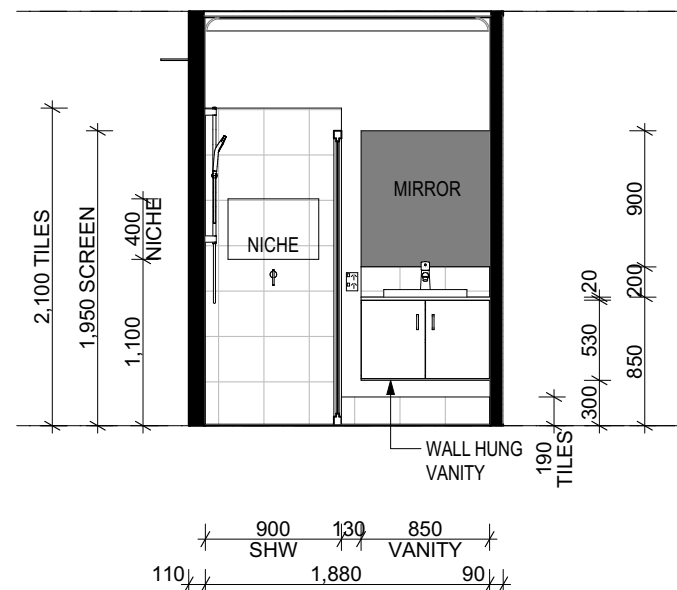


Bathroom D

Scale 1:50

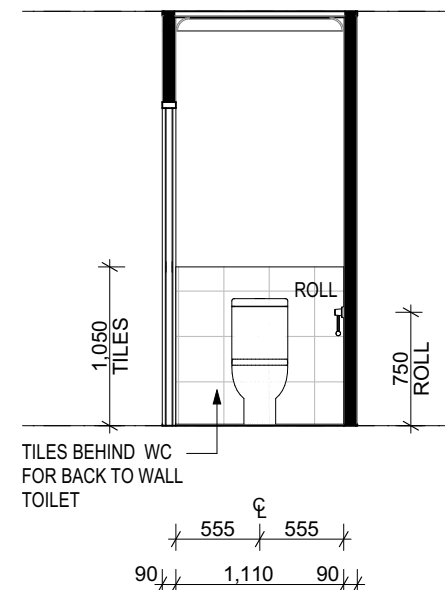

Wc E

Scale 1:50

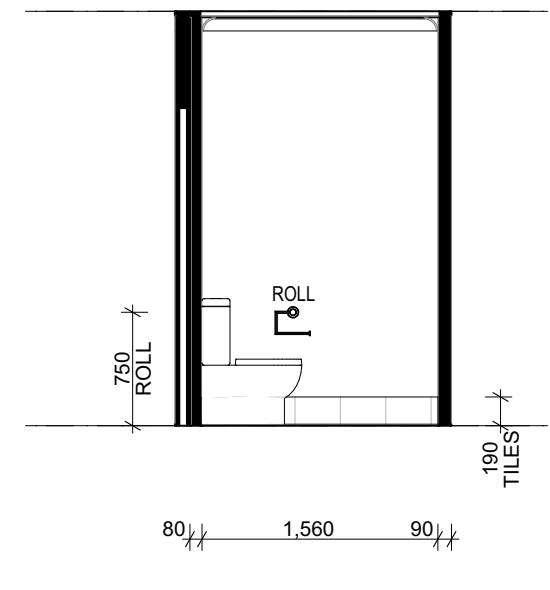

Wc F

Scale 1:50

Copyright Notice: All house plans produced by the builder and the information contained within these documents are the exclusive property of the builder. These house plans cannot be copied or reproduced, in part or in whole in any form or by any method without the express written consent of the builder. The house plans provided by the builder are only to be constructed by Stroud Homes.

Notes:

UPGRADE ITEMS SHOWN IN RED

Dimensions shall not be obtained by scaling. All dimensions are in millimeters unless noted otherwise. Setout dimensions shall be verified on site prior to any work being carried out. Any problems shall be directed to the builder for clarification & correction



Madden Developments Pty Ltd
ABN: 52 169 872 486
QBSA Lic No: 1284666
107 Sugar Road Maroochydore QLD 4558,
Phone: 07 5444 2521
Email: scadmin@stroudhomes.com.au

Client
Sheree & Merren Bailey
Project
LOT 3 #20 LAUREL STREET, MALENY, QLD 4552

Drawing name:
Bathroom Layout

Project status:
CONSTRUCTION

Design: HEARTWOOD 222

Proj. No. 3LAUREL

REVISION R3

CONSTRUCTION PLAN SET 02/03/26 AT

R1 MARK UPS 20/03/26 AT

R2 MARK UPS 21/03/26 BT

R3 MARK UPS 08/05/26 BT

Wind class:

N3 TBC

Soil class:

TBC

Plot date:

12/05/2026

Flood level:

TBC

BAL:

TBC

Noise:


TBC

Scale:

1:50 @A3

A0.11

© My Draw2 - Projects/REGD - LAUREL CROSS LOT 3 LAUREL ST - LAUREL, QLD

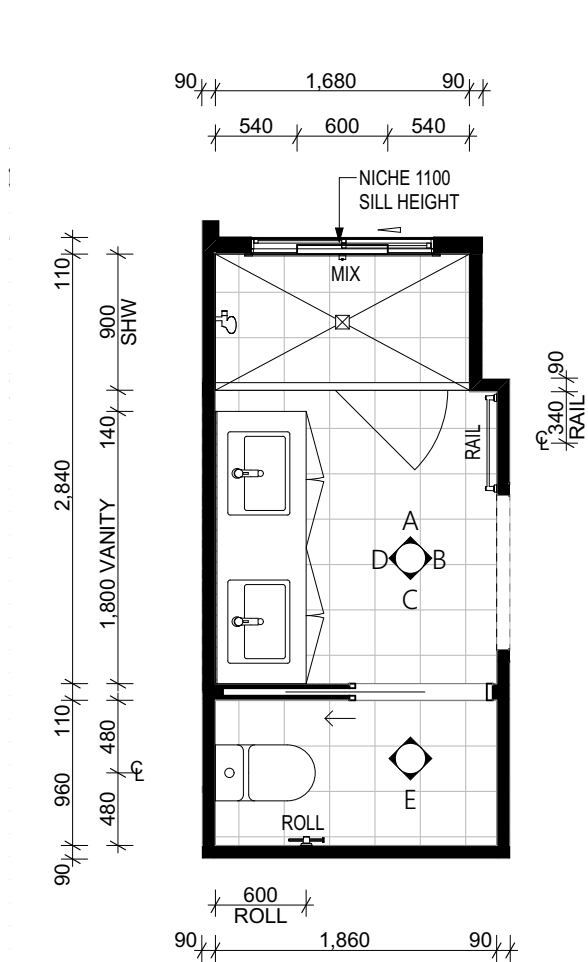


ENSUITE NOTE:
- PROVIDE REINFORCING TO WALLS IN ENSUITE. REFER TO BATHROOM REINFORCING SHEET


ENSUITE NOTE:
- SQUARE SET CEILING TO ENSUITE FOR FULL HEIGHT TILING IN SHOWER AREA

Ensuite Plan
Scale 1:50


DISCLAIMER NOTE:
The builder has identified that occasionally cabinetry layouts, plumbing locations, and fit off items are not achievable. Final cabinetry layouts, plumbing setouts, and fit off item locations & dimensions are approximate only & are subject to change. Final shop drawings are to be completed by a suitably qualified contractor to ensure that all works are carried out to meet relevant building codes. The builder endeavors to provide an exact layout but this is not always possible. Dimensions shown are from the outside of the plasterboard and not from frame. Site measure required before cabinetry design and benchtop production.

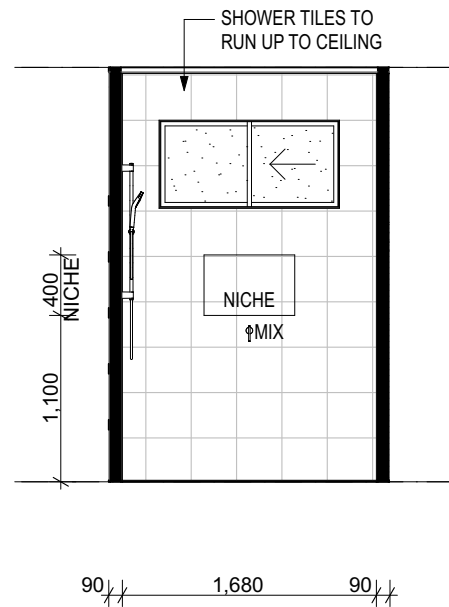


Ensuite A
Scale 1:50

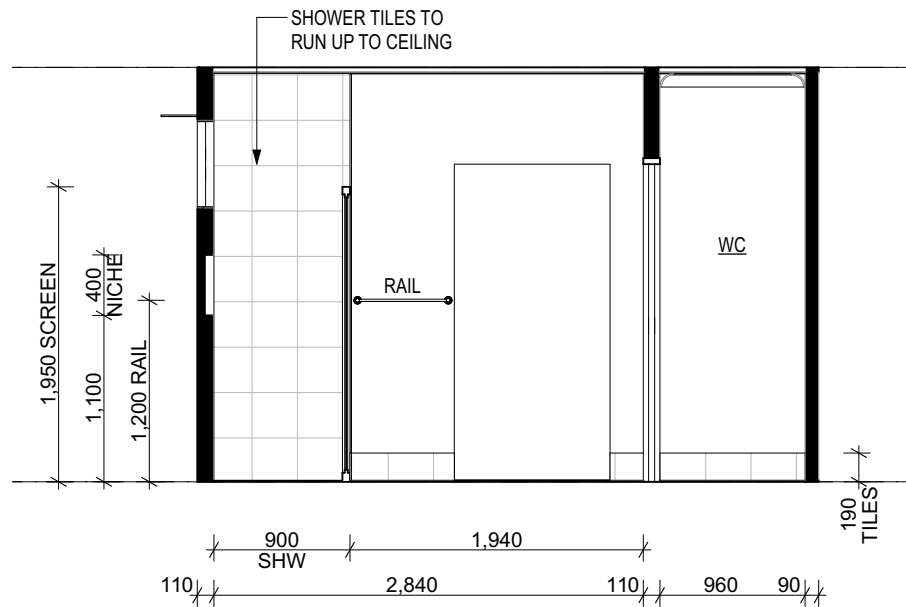


Ensuite B
Scale 1:50

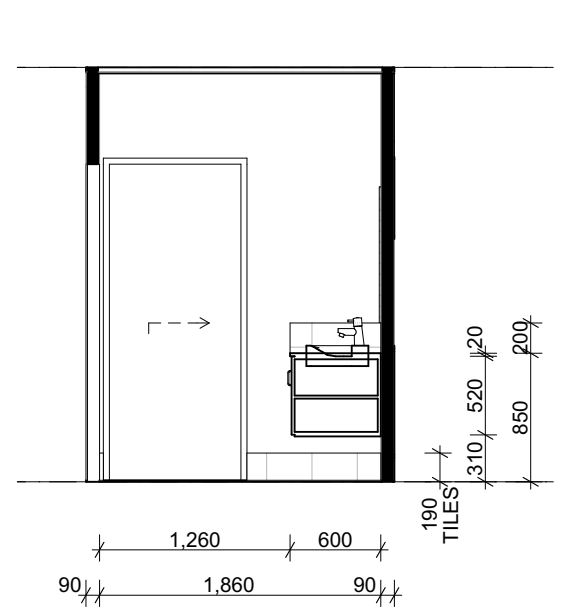

Ensuite C
Scale 1:50

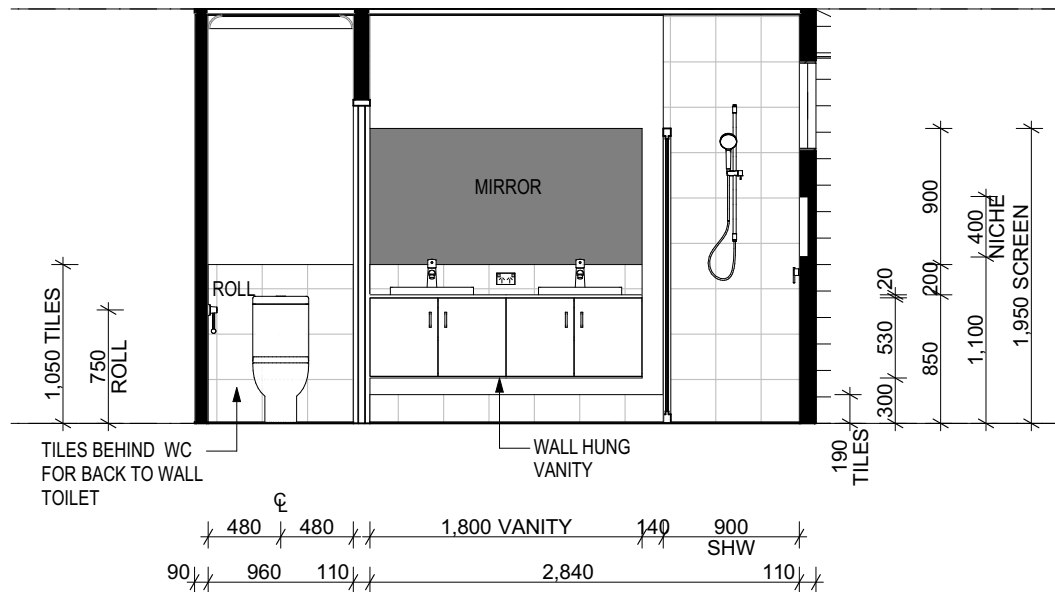

Ensuite D
Scale 1:50

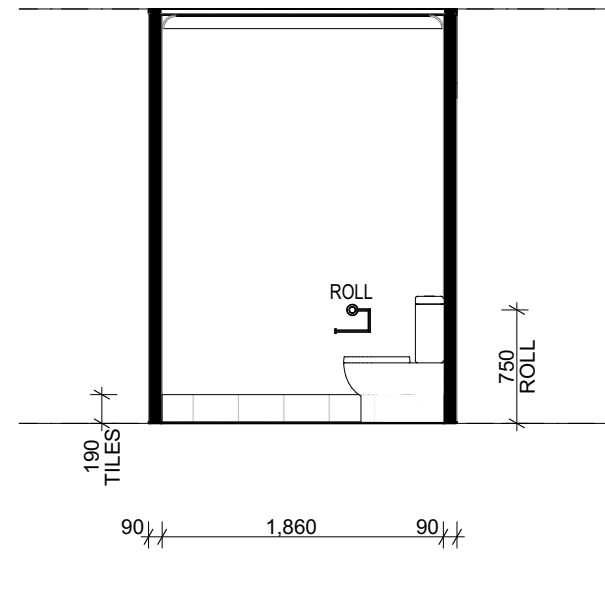

Ensuite E
Scale 1:50

Copyright Notice: All house plans produced by the builder and the information contained within these documents are the exclusive property of the builder. These house plans cannot be copied or reproduced, in part or in whole in any form or by any method without the express written consent of the builder. The house plans provided by the builder are only to be constructed by Stroud Homes.

Notes:
UPGRADE ITEMS SHOWN IN RED
Dimensions shall not be obtained by scaling. All dimensions are in millimeters unless noted otherwise. Setout dimensions shall be verified on site prior to any work being carried out. Any problems shall be directed to the builder for clarification & correction



Madden Developments Pty Ltd
ABN: 52 169 872 486
QBSA Lic No: 1284666
107 Sugar Road Maroochydore QLD 4558,
Phone: 07 5444 2521
Email: scadmin@stroudhomes.com.au

Client
Sheree & Merren Bailey
Project
LOT 3 #20 LAUREL STREET, MALENY, QLD 4552

Drawing name:
Ensuite Layout
Project status:
CONSTRUCTION
Design: HEARTWOOD 222
Proj. No. 3LAUREL


REVISION R3	
CONSTRUCTION PLAN SET 02/03/26 AT	
R1 MARK UPS 20/03/26 AT	
R2 MARK UPS 21/03/26 BT	
R3 MARK UPS 08/05/26 BT	

Wind class: N3 TBC	Flood level: TBC	Scale: 1:50 @A3
Soil class: TBC	BAL: TBC	
Plot date: 12/05/2026	Noise: TBC	A0.12




The builder has identified that occasionally cabinetry layouts, plumbing locations, and fit off items are not achievable. Final cabinetry layouts, plumbing setouts, and fit off item locations & dimensions are approximate only & are subject to change. Final shop drawings are to be completed by a suitably qualified contractor to ensure that all works are carried out to meet relevant building codes. The builder endeavors to provide an exact layout but this is not always possible. Dimensions shown are from the outside of the plasterboard and not from frame. Site measure required before cabinetry design and benchtop production.



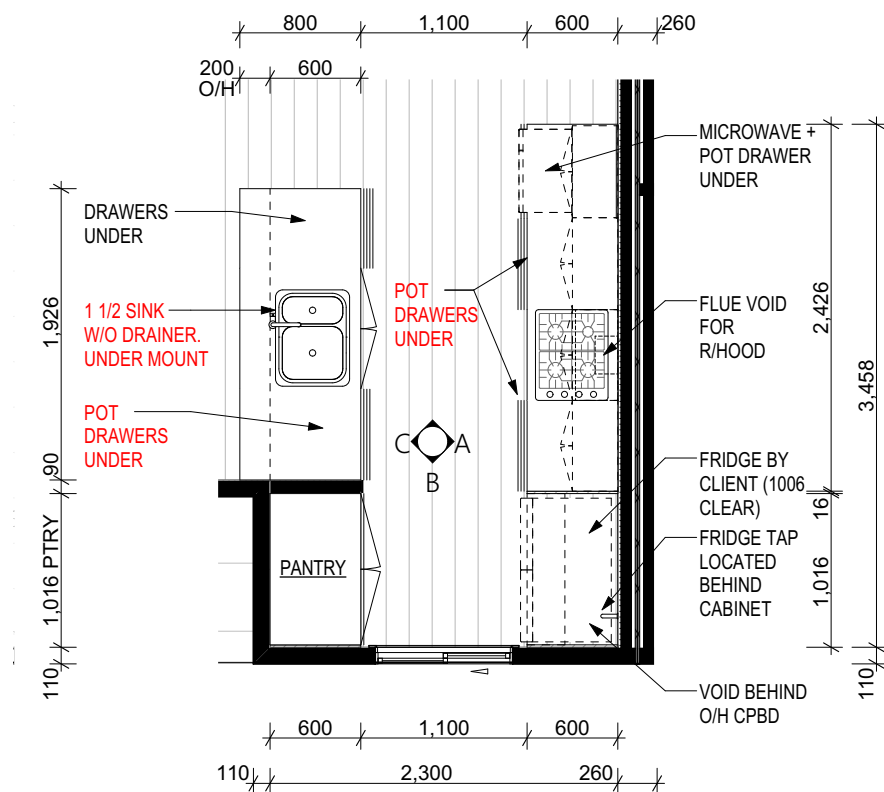


GF Kitchen Plan
Scale 1:50


DISCLAIMER NOTE:
The builder has identified that occasionally cabinetry layouts, plumbing locations, and fit off items are not achievable. Final cabinetry layouts, plumbing setouts, and fit off item locations & dimensions are approximate only & are subject to change. Final shop drawings are to be completed by a suitably qualified contractor to ensure that all works are carried out to meet relevant building codes. The builder endeavors to provide an exact layout but this is not always possible.
Dimensions shown are from the outside of the plasterboard and not from frame. Site measure required before cabinetry design and benchtop production.

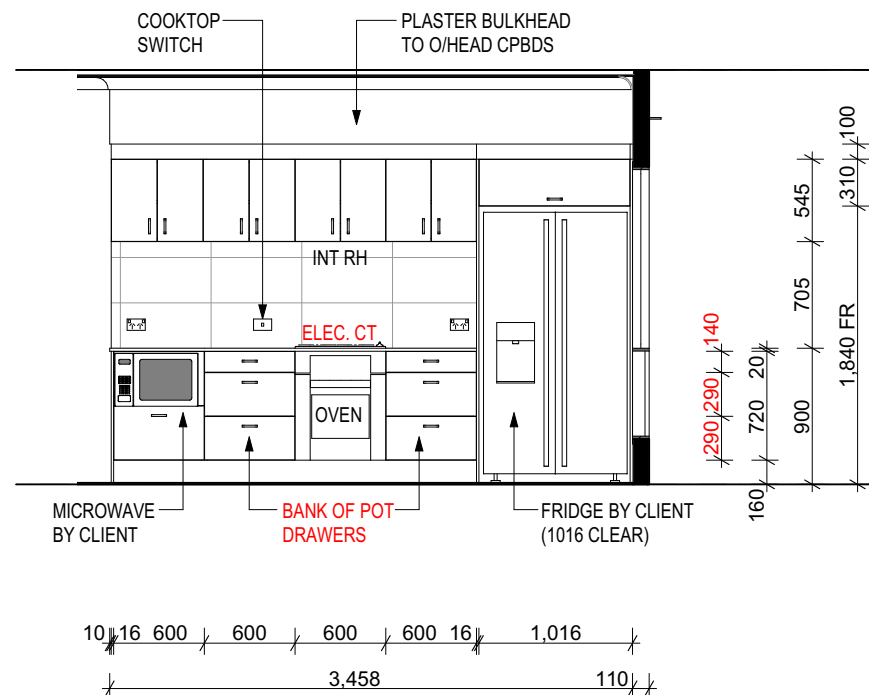

GF Kitchen A
Scale 1:50

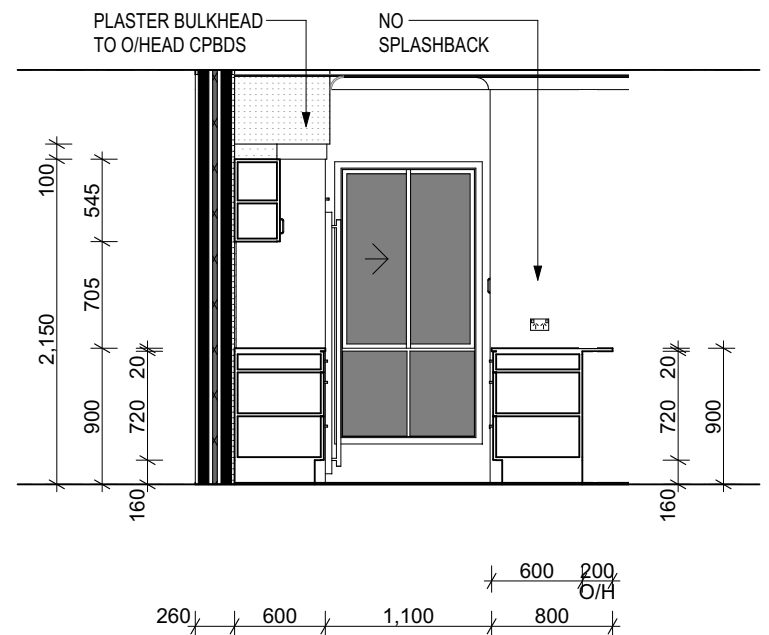

GF Kitchen B
Scale 1:50

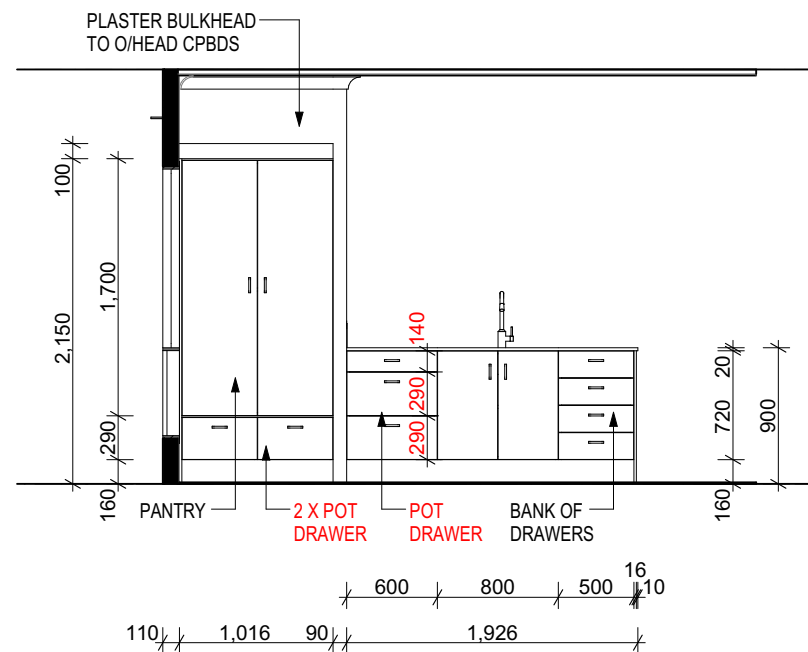

GF Kitchen C
Scale 1:50

Copyright Notice: All house plans produced by the builder and the information contained within these documents are the exclusive property of the builder. These house plans cannot be copied or reproduced, in part or in whole in any form or by any method without the express written consent of the builder. The house plans provided by the builder are only to be constructed by Stroud Homes.

Notes:
UPGRADE ITEMS SHOWN IN RED
Dimensions shall not be obtained by scaling. All dimensions are in millimeters unless noted otherwise. Setout dimensions shall be verified on site prior to any work being carried out. Any problems shall be directed to the builder for clarification & correction



Madden Developments Pty Ltd
ABN: 52 169 872 486
QBSA Lic No: 1284666
107 Sugar Road Maroochydore QLD 4558,
Phone: 07 5444 2521
Email: scadmin@stroudhomes.com.au

Client:
Sheree & Merren Bailey
Project:
LOT 3 #20 LAUREL STREET, MALENY, QLD 4552

Drawing name:
GF Kitchen Layout
Project status:
CONSTRUCTION
Design: HEARTWOOD 222

Proj. No. 3LAUREL

REVISION R3	
CONSTRUCTION PLAN SET 02/03/26 AT	
R1 MARK UPS 20/03/26 AT	
R2 MARK UPS 21/03/26 BT	
R3 MARK UPS 08/05/26 BT	


Wind class:	N3 TBC	Flood level:	TBC	Scale:	1:50 @A3
Soil class:	TBC	BAL:	TBC		
Plot date:	12/05/2026	Noise:	TBC		A0.14

Drawn: J. M. 12/05/2026, Checked: J. M. 12/05/2026, Project: 3LAUREL, Drawing: GF Kitchen Layout, Scale: 1:50, Project Status: CONSTRUCTION, Design: HEARTWOOD 222, Project No: 3LAUREL




The builder has identified that occasionally cabinetry layouts, plumbing locations, and fit off items are not achievable. Final cabinetry layouts, plumbing setouts, and fit off item locations & dimensions are approximate only & are subject to change. Final shop drawings are to be completed by a suitably qualified contractor to ensure that all works are carried out to meet relevant building codes. The builder endeavors to provide an exact layout but this is not always possible. Dimensions shown are from the outside of the plasterboard and not from frame. Site measure required before cabinetry design and benchtop production.




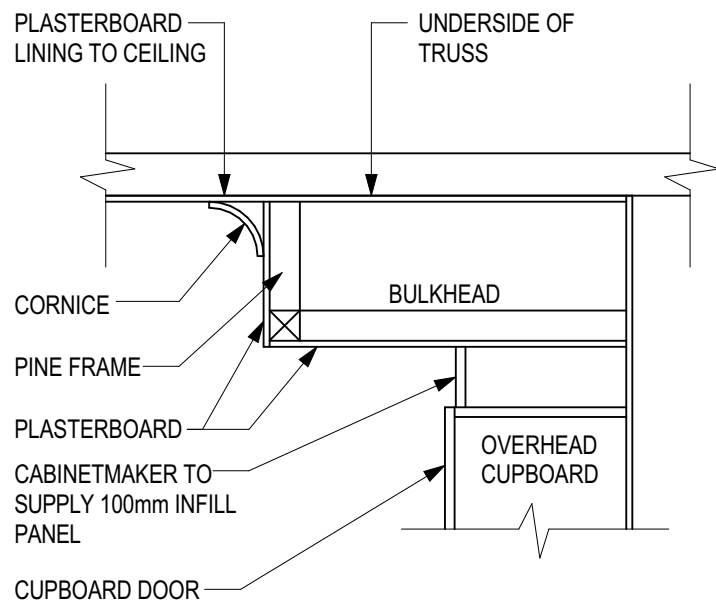


KITCHEN BULKHEAD DETAIL SCALE: N.T.S.

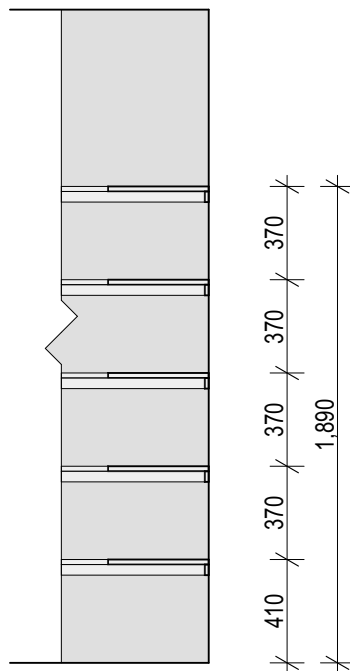


PANTRY SHELVING DETAIL (TYPICAL)

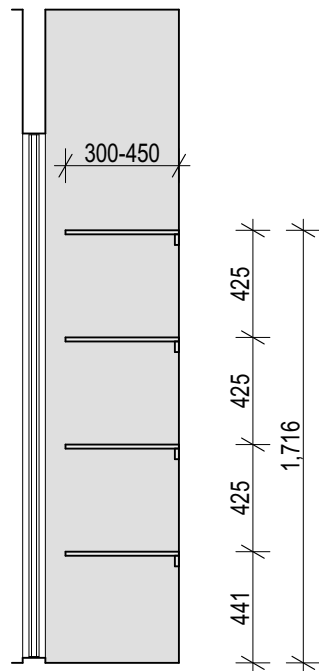


LINEN SHELVING DETAIL (TYPICAL)

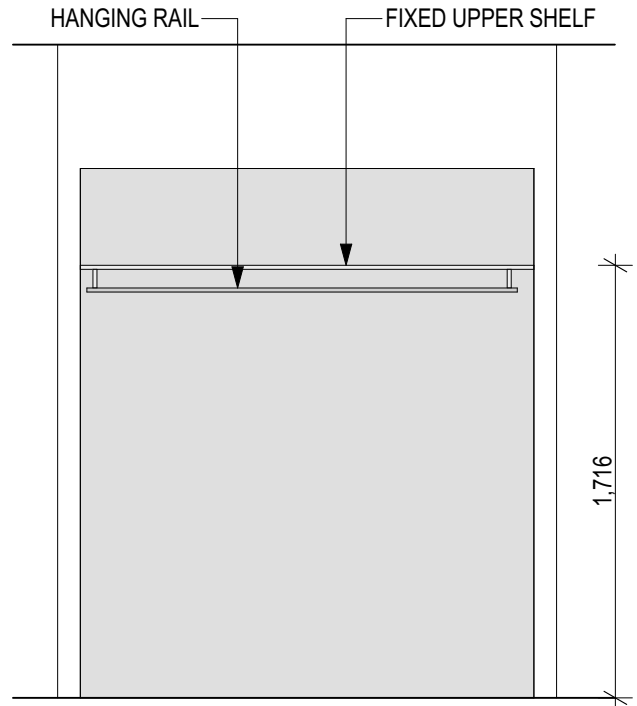

ROBE SINGLE HUNG DETAIL (TYPICAL)

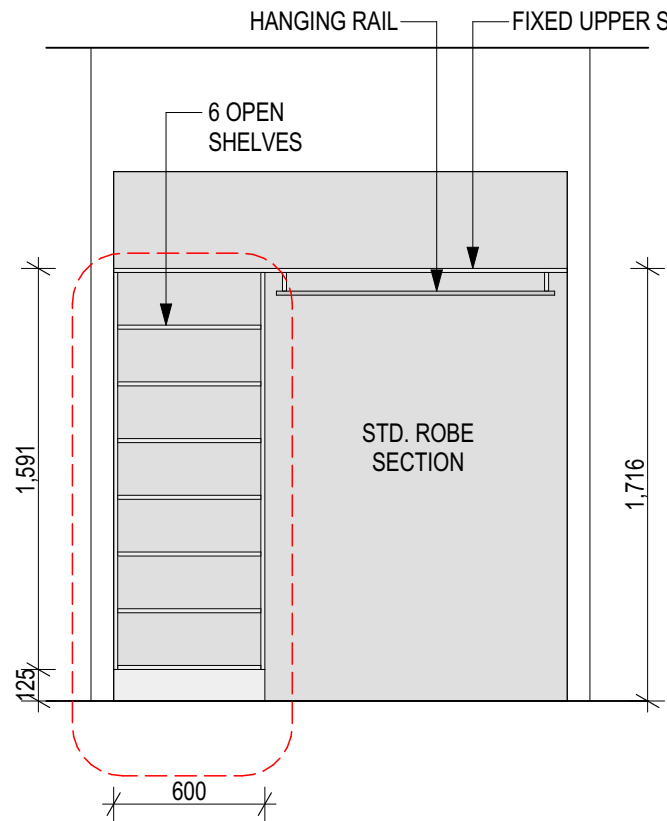

ROBE UPGRADE 1

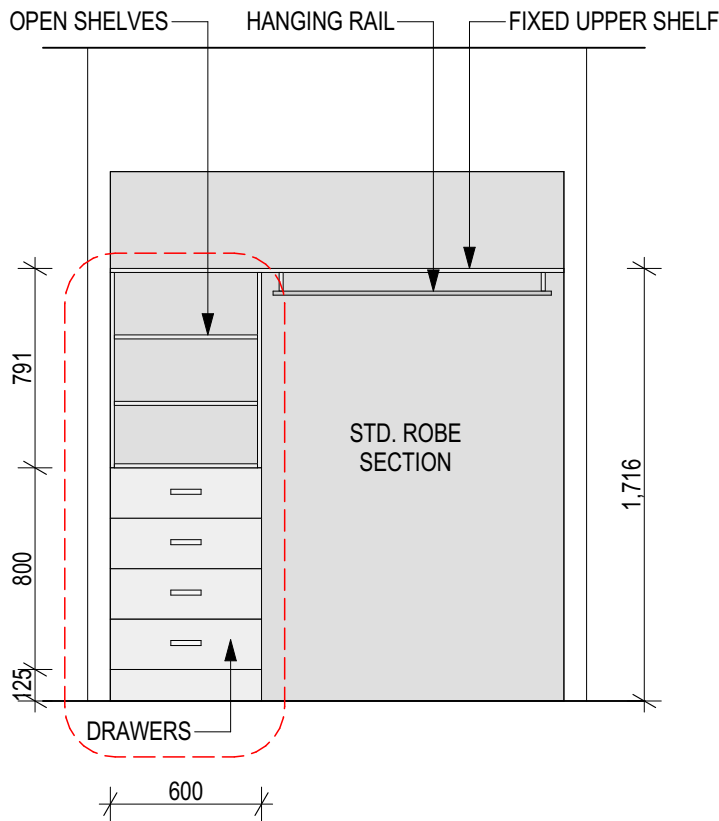

ROBE UPGRADE 2

DISCLAIMER NOTE:
The builder has identified that occasionally cabinetry layouts, plumbing locations, and fit off items are not achievable. Final cabinetry layouts, plumbing setouts, and fit off item locations & dimensions are approximate only & are subject to change. Final shop drawings are to be completed by a suitably qualified contractor to ensure that all works are carried out to meet relevant building codes. The builder endeavors to provide an exact layout but this is not always possible.
Dimensions shown are from the outside of the plasterboard and not from frame. Site measure required before cabinetry design and benchtop production.

Copyright Notice: All house plans produced by the builder and the information contained within these documents are the exclusive property of the builder. These house plans cannot be copied or reproduced, in part or in whole in any form or by any method without the express written consent of the builder. The house plans provided by the builder are only to be constructed by Stroud Homes.

Notes:
■ **UPGRADE ITEMS SHOWN IN RED**
Dimensions shall not be obtained by scaling. All dimensions are in millimeters unless noted otherwise. Setout dimensions shall be verified on site prior to any work being carried out. Any problems shall be directed to the builder for clarification & correction



Madden Developments Pty Ltd
ABN: 52 169 872 486
QBSA Lic No: 1284666
107 Sugar Road Maroochydore QLD 4558,
Phone: 07 5444 2521
Email: scadmin@stroudhomes.com.au

Client
Sheree & Merren Bailey
Project
LOT 3 #20 LAUREL STREET, MALENY, QLD 4552

Drawing name:
Joinery Details
Project status:
CONSTRUCTION

Design: HEARTWOOD 222 Proj. No. 3LAUREL


REVISION R3	
CONSTRUCTION PLAN SET 02/03/26 AT	
R1 MARK UPS 20/03/26 AT	
R2 MARK UPS 21/03/26 BT	
R3 MARK UPS 08/05/26 BT	

Wind class: **N3 TBC**
Soil class: **TBC**
Plot date: **12/05/2026**


Flood level: **TBC**
BAL: **TBC**
Noise: **TBC**

Scale: **@A3**
A0.16

BATHROOM WALL REINFORCING DETAILS

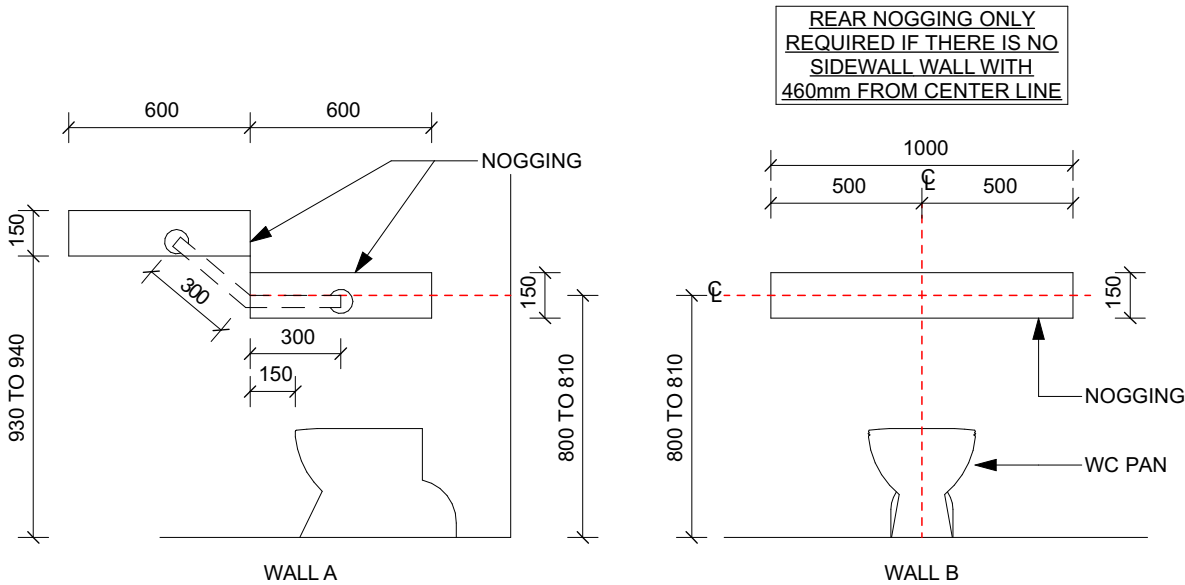

1. WC REINFORCEMENT (SCALE 1:30)

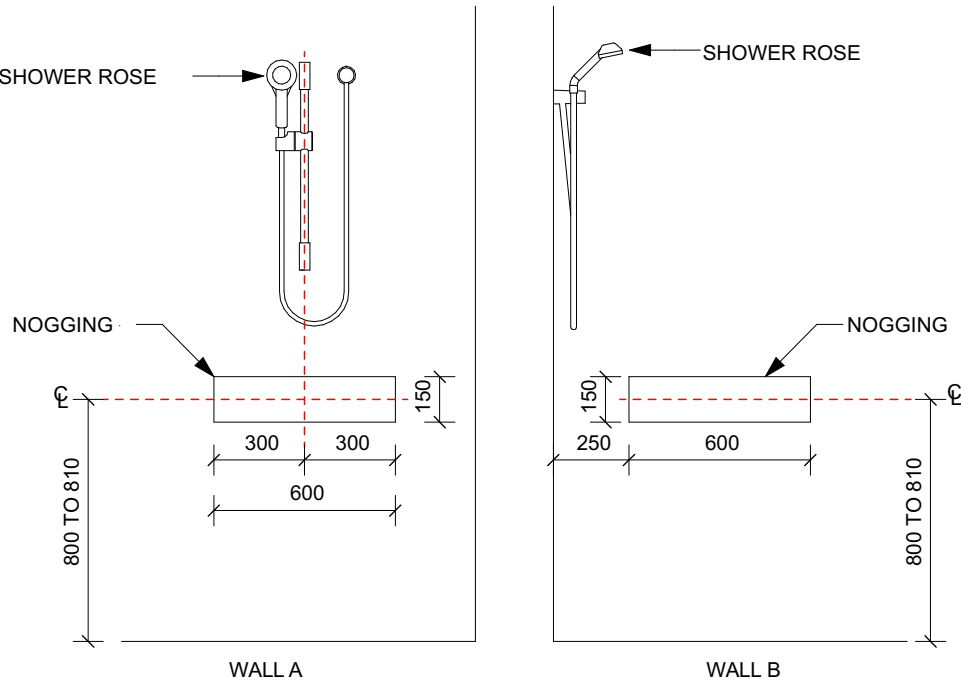

2. SHOWER REINFORCEMENT (SCALE 1:30)

REINFORCING NOTES:


EXCLUDING A WALL BEHIND A TOILET PAN; REINFORCING NEED ONLY BE PROVIDED ACROSS THE AVAILABLE WIDTH OF THE WALL WHERE A WALL REFERRED TO IS NARROWER THAN THE WIDTH OF THE AREA REQUIRED TO BE PROVIDED WITH REINFORCING; OR TERMINATES AT A WINDOW SILL LOWER THAN THE HEIGHT OR THE AREA REQUIRED TO BE PROVIDED WITH REINFORCING.

REINFORCING MUST BE CONSTRUCTED USING ONE OF THE FOLLOWING MATERIALS:
- A MINIMUM OF 12 MM THICK STRUCTURAL GRADE PLYWOOD, OR SIMILAR.
- TIMBER NOGGINGS WITH A MINIMUM THICKNESS OF 25 MM.
- LIGHT GAUGE STEEL FRAMING NOGGINGS OR METAL PLATE IN ACCORDANCE WITH THE NASH STANDARD.

TAPS, BATH NICHES, SOAP HOLDERS AND THE LIKE MAY BE LOCATED WITHIN THE POSITIONS DESIGNATED FOR WALL REINFORCING.

WHERE THE HEIGHT OF THE BATH TUB IS NOT YET KNOWN, AN ASSUMED HEIGHT OF 500 MM ABOVE FINISHED FLOOR LEVEL MAY BE USED TO DETERMINE THE LOCATION OF WALL REINFORCING.

IF USING SHEETING REINFORCING REFER TO THE LIVABLE HOUSING DESIGN STANDARD FOR LOCATION REQUIREMENTS

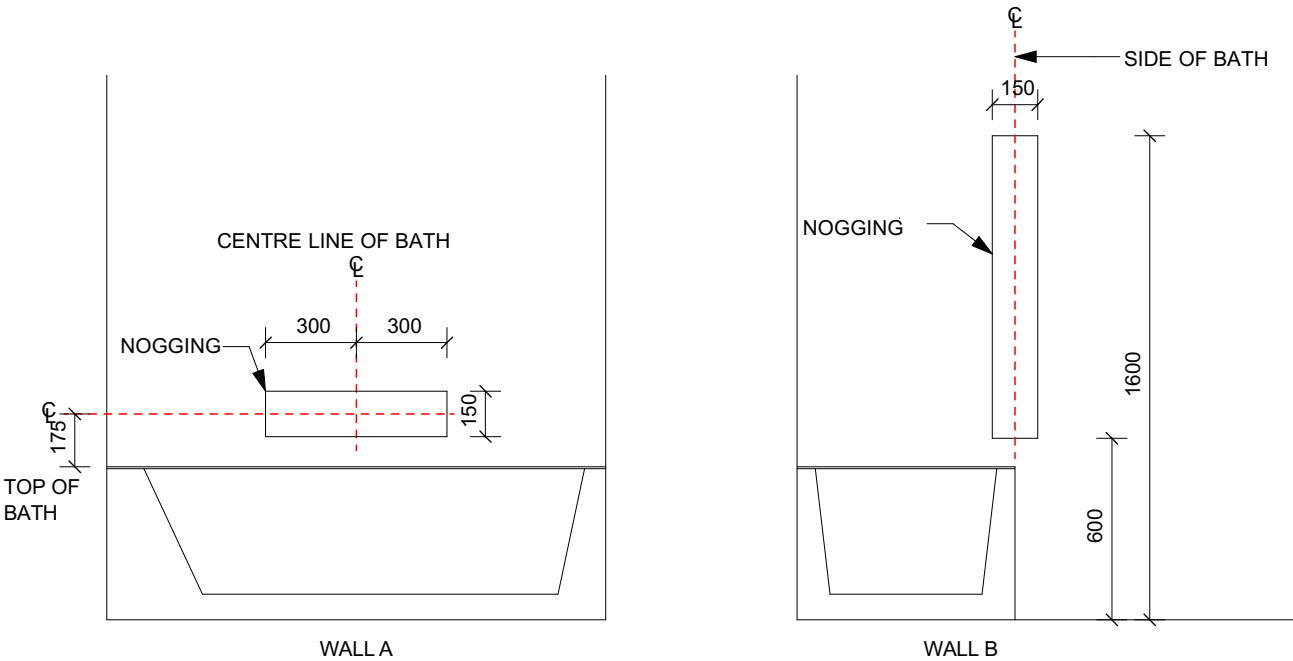

3. BATH REINFORCEMENT (SCALE 1:30)

Copyright Notice: All house plans produced by the builder and the information contained within these documents are the exclusive property of the builder. These house plans cannot be copied or reproduced, in part or in whole in any form or by any method without the express written consent of the builder. The house plans provided by the builder are only to be constructed by Stroud Homes.

Notes:
UPGRADE ITEMS SHOWN IN RED
Dimensions shall not be obtained by scaling. All dimensions are in millimeters unless noted otherwise. Setout dimensions shall be verified on site prior to any work being carried out. Any problems shall be directed to the builder for clarification & correction



Madden Developments Pty Ltd
ABN: 52 169 872 486
QBSA Lic No: 1284666
107 Sugar Road Maroochydore QLD 4558,
Phone: 07 5444 2521
Email: scadmin@stroudhomes.com.au


Client
Sheree & Merren Bailey
Project
LOT 3 #20 LAUREL STREET, MALENY,
QLD 4552

Drawing name:
Bathroom Reinforcing Details
Project status:
CONSTRUCTION
Design: HEARTWOOD 222
Proj. No. 3LAUREL

REVISION R3	
CONSTRUCTION PLAN SET 02/03/26 AT	
R1 MARK UPS 20/03/26 AT	
R2 MARK UPS 21/03/26 BT	
R3 MARK UPS 08/05/26 BT	

Wind class: N3 TBC	Flood level: TBC
Soil class: TBC	BAL: TBC
Plot date: 12/05/2026	Noise: TBC

Scale:
@A3
A0.17

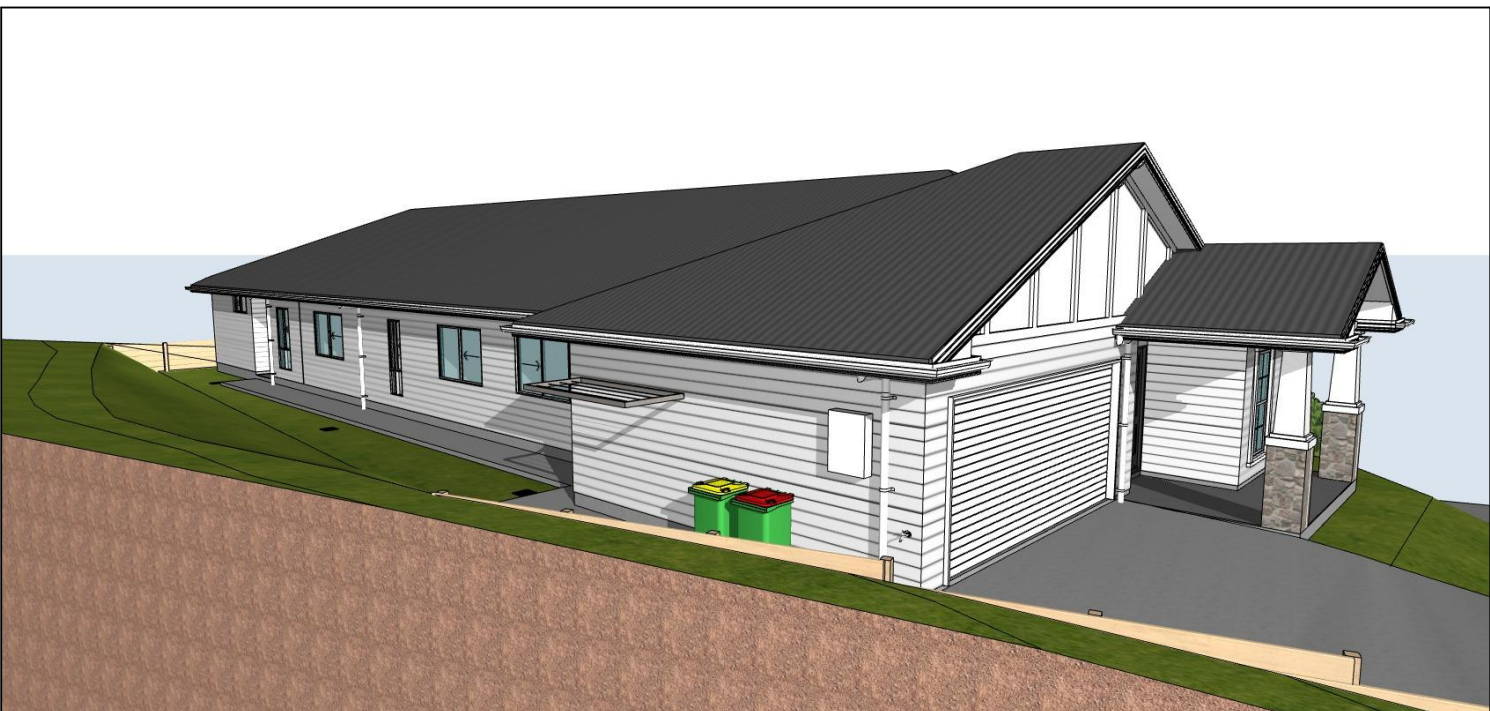

Scale:	@A3
A0.18	

--	--	--